

Name

Service No.

Address 22 Rangeway

Location

Kind of Pipe

Size 6"

Size of Main 8"

Repair—Renewal—New Service

Location


Date	Material	Amount	Total		Date			Amount
1968	To go thru easement per Mr. Jones Engineering Dept.	NO CHARGE						

DATE _____

TOWN OF LEXINGTON — BOARD OF PUBLIC WORKS

SEWER DIVISION

Sketch of Service Here **22**

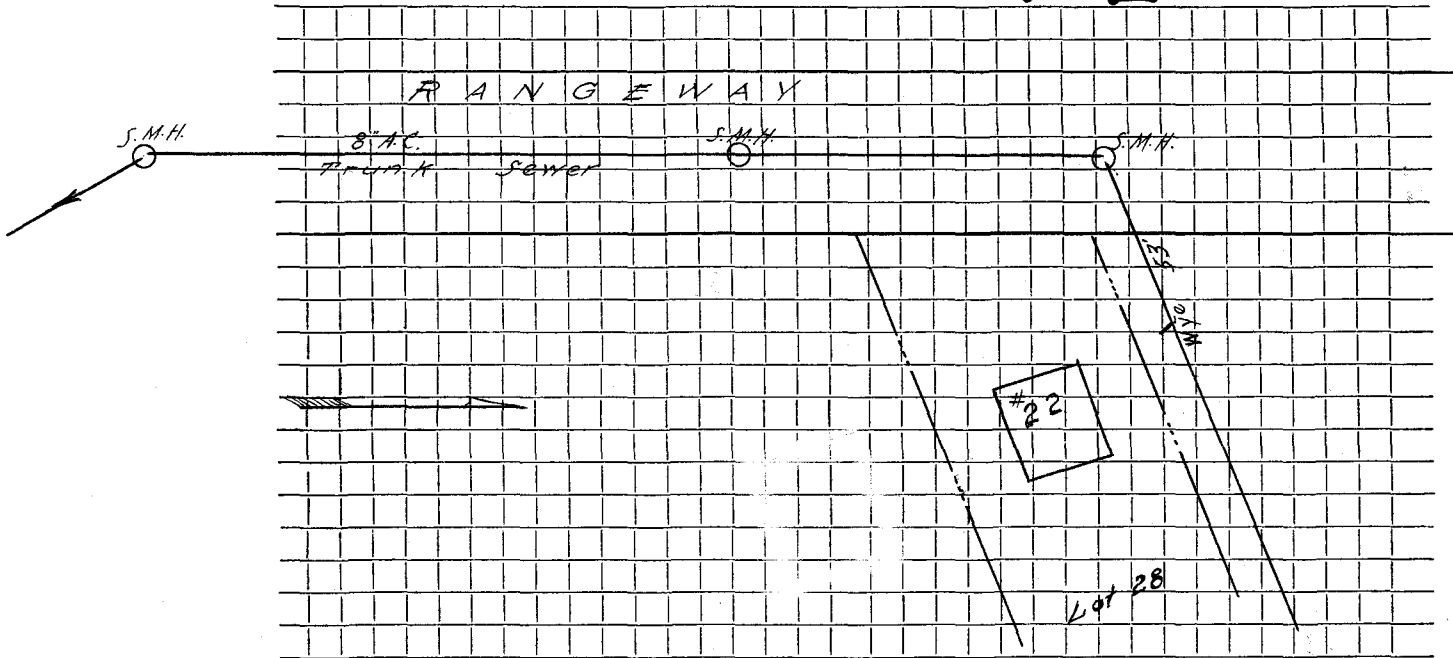

Connection made in Street. Work completed

Remarks: To go thru easement no change
.....
.....