




DATE \_\_\_\_\_

TOWN OF LEXINGTON — BOARD OF PUBLIC WORKS  
SEWER DIVISION

Sketch of Service Here **23**

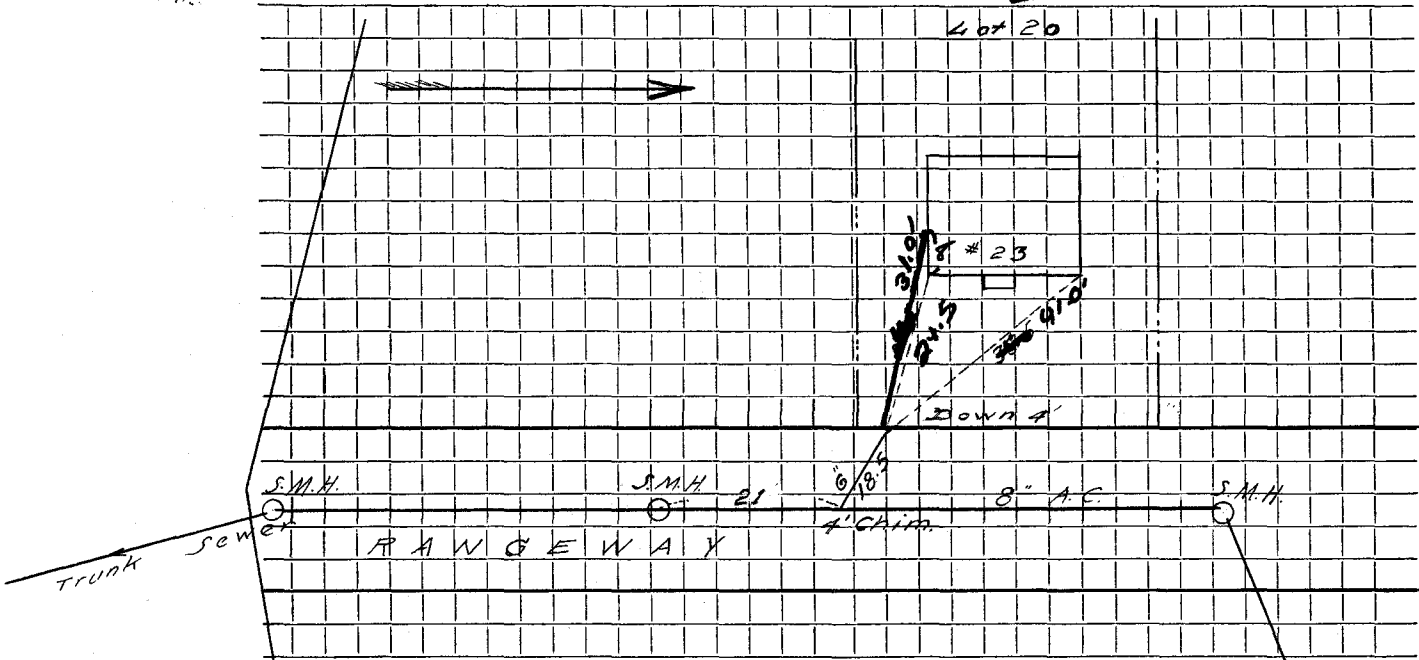

Connection made in 23 RANGEWAY Street. Work completed 10/15/75

Remarks: .....

.....

.....