

Name *Frederick Berroge*

Service No. 11

Address 25 Rangeway

Lot 21

Location

Kind of Pipe

Size

Size of Main

Repair—Renewal—New Service Valeri #4015
XXXXXXXXXXXXXXXXXXXX


Location JUN 17 1985

Date	Material	Amount	Total	Date	Amount
1968	18' 6" Transite pipe @7.00		126.00	4-19-85	126.00
4/25/85	48' 6" PVC				
	1 Donut				
	1 PVC to Transite Adapt.				

DATE _____

TOWN OF LEXINGTON — BOARD OF PUBLIC WORKS
SEWER DIVISION

Sketch of Service Here **25**

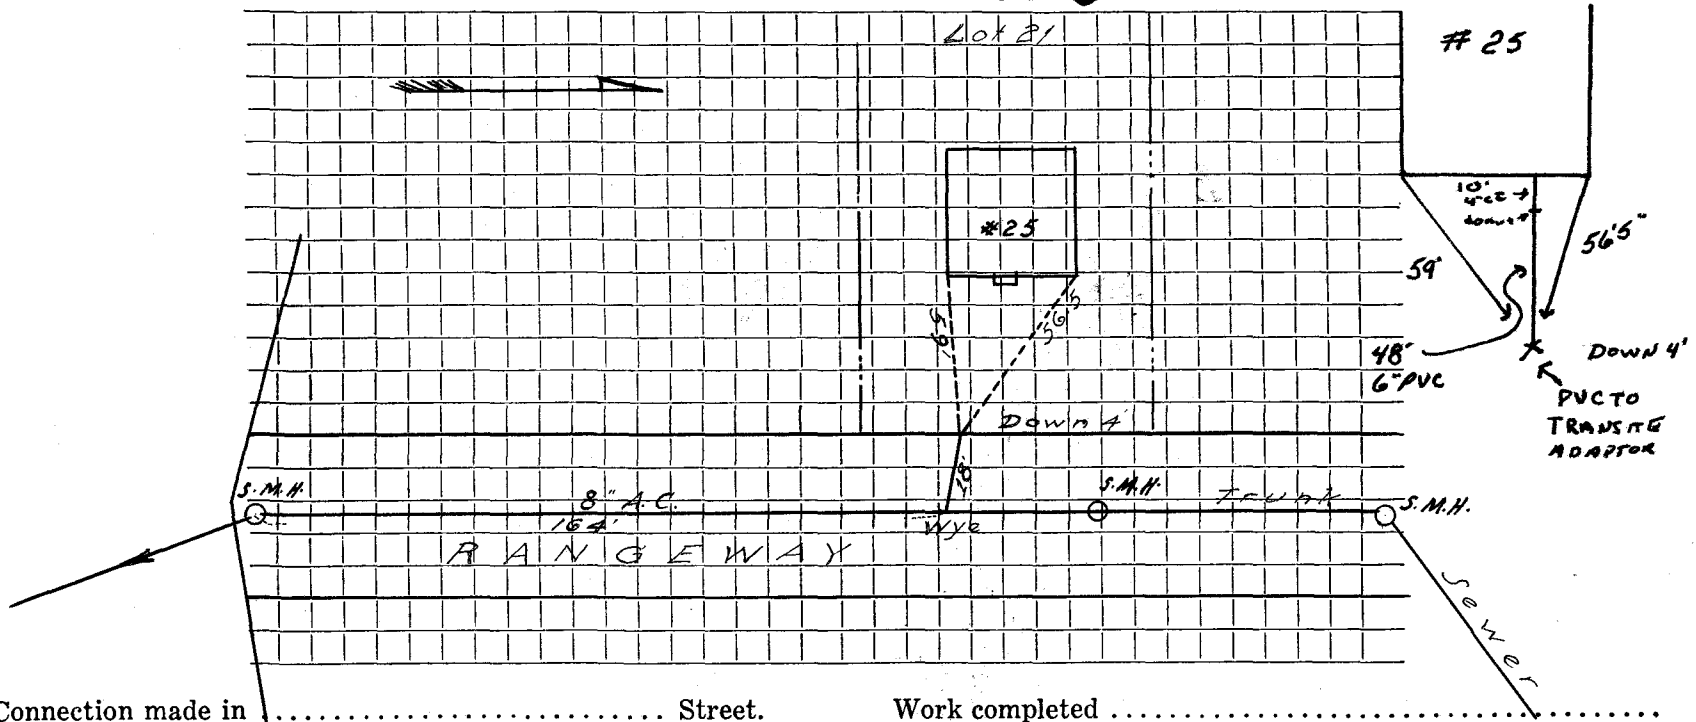

Connection made in Street. Work completed

Remarks:

.....
.....
.....