

Name Ron Papierski

Service No. 38

Address 27 Rangeway

Lot 22 & 23

Location

Kind of Pipe

Size

Size of Main

~~Repair/Renewal~~ New Service Valeri #3900

Location NOV 19 1984


Date		Material	Amount	Total	Date		Amount
1968	24 $\frac{1}{2}$ '	6" Transite pipe @7.00		171.50	9-25-84	<i>Deposit</i>	171.50
10/25/84	75'	6" PVC					
	1	22 <sup>o</sup> Sweep					
	1	AC to PVC Adpt					
	1	4" x 6" Donut					

DATE \_\_\_\_\_

TOWN OF LEXINGTON — BOARD OF PUBLIC WORKS

SEWER DIVISION

Sketch of Service Here **27**

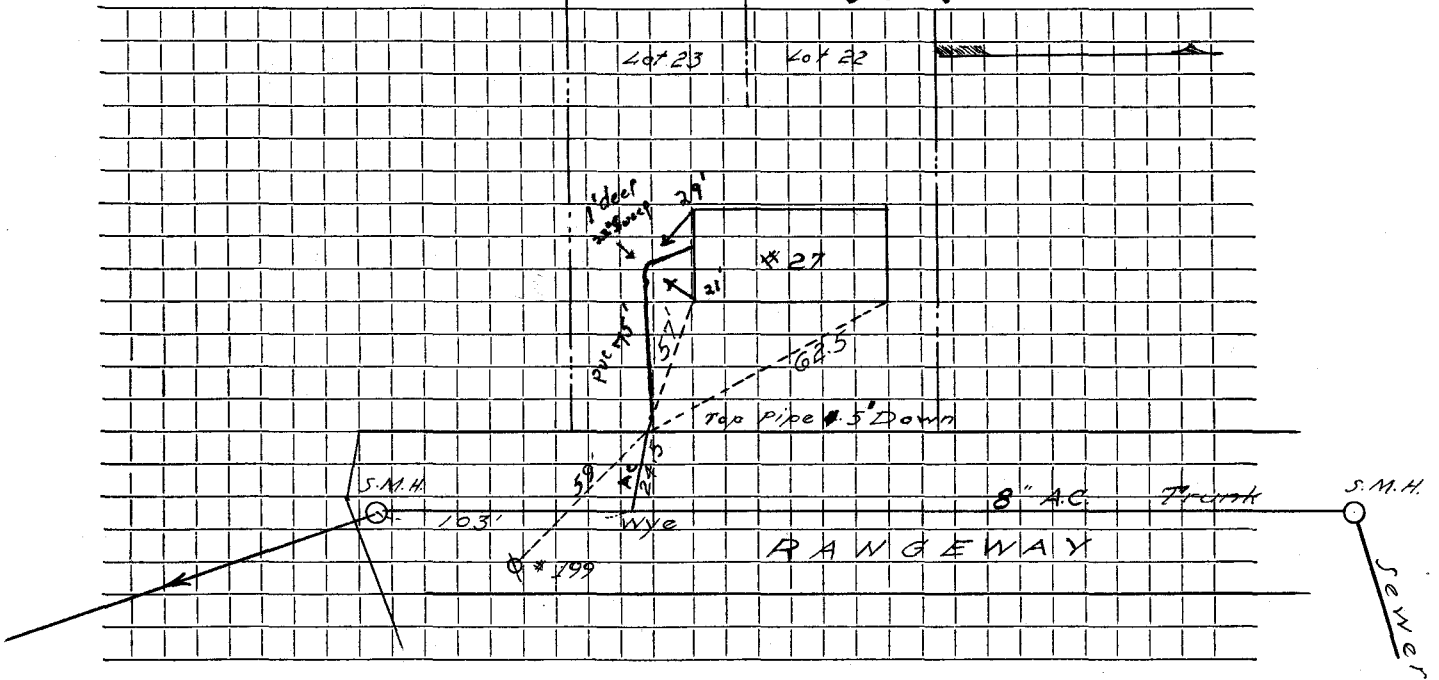

Connection made in ..... Street. Work completed .....

Remarks: .....  
.....  
.....