

Name William R. Reid

**Service No. 30**

1977

**Address** 4 RANGEWAY

## 4. Range way

## **Locations**

JUN 20 1977

**Kind of Pipe** A C

Size 6 1/4

Size of Main 8"

**Post-Newsweek** - New Service

Griecci #3160

## **Location**


DATE \_\_\_\_\_

TOWN OF LEXINGTON — BOARD OF PUBLIC WORKS

SEWER DIVISION

Sketch of Service Here

4

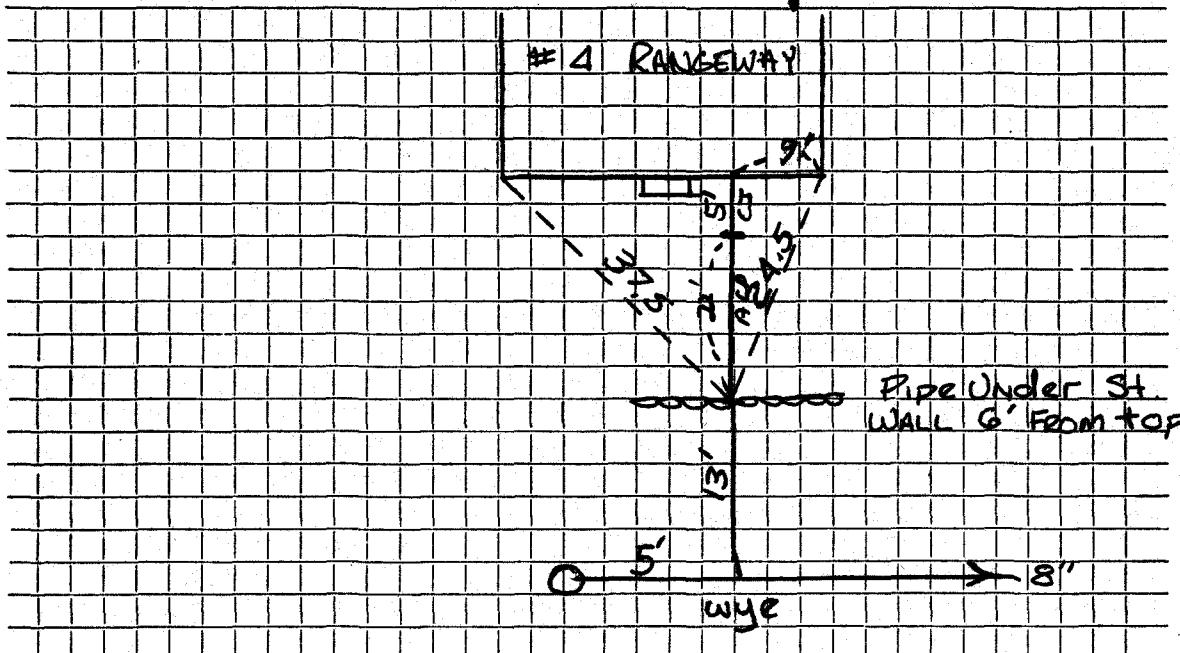

Connection made in ... RANGEWAY ..... Street. Work completed .....

Remarks: .....