

16/18


DATE _____

TOWN OF LEXINGTON — BOARD OF PUBLIC WORKS

SEWER DIVISION

Sketch of Service Here

Lex Hab

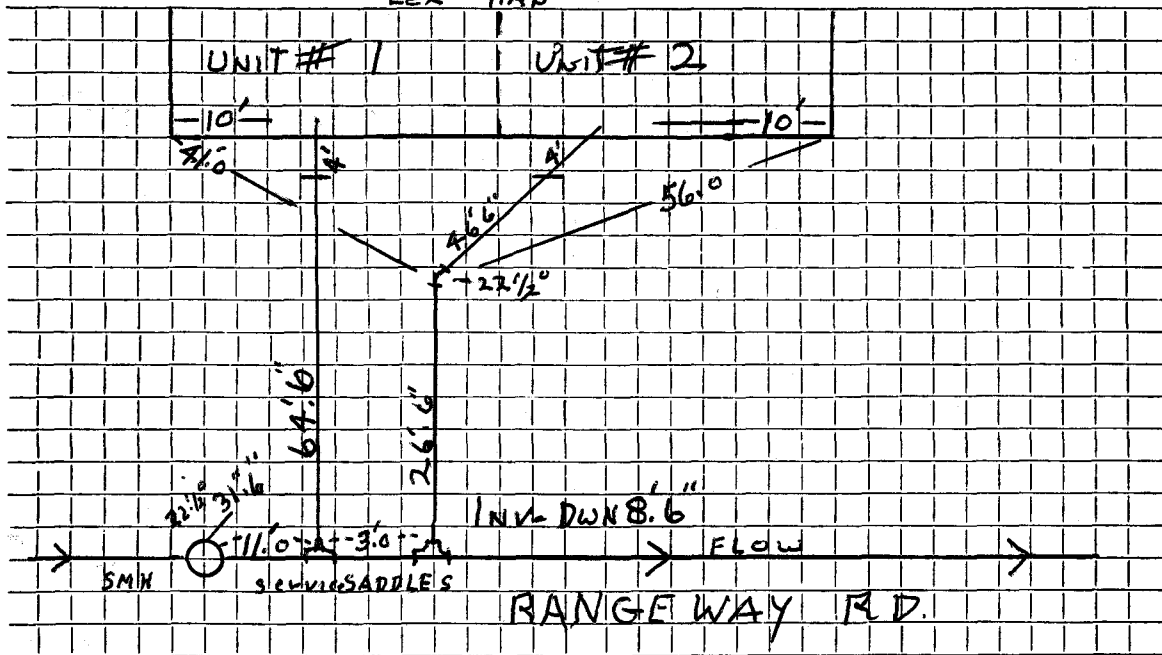

Connection made in Street. Work completed 10/11/04

Remarks:

.....

.....