


DATE _____

TOWN OF LEXINGTON — BOARD OF PUBLIC WORKS
SEWER DIVISION

Sketch of Service Here

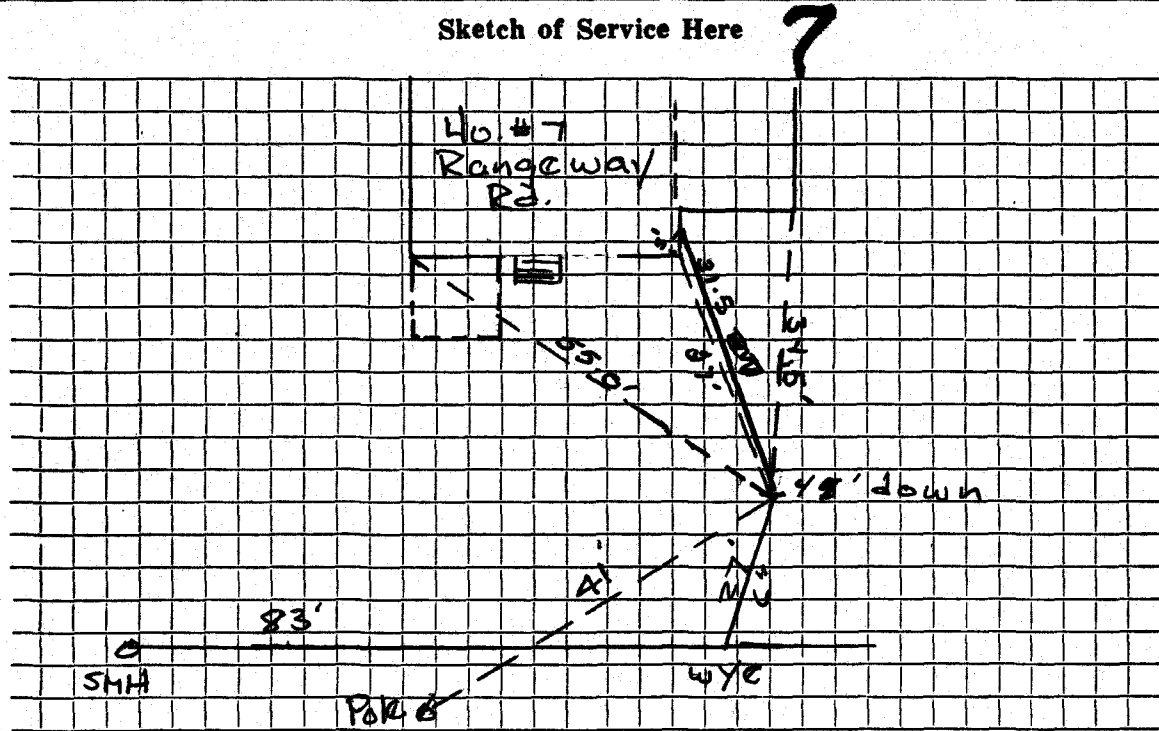

Connection made in 7 Rangeway Rd. Street. Work completed 10/15/15

Remarks:

.....

.....