




DATE 9/6/2016

TOWN OF LEXINGTON — BOARD OF PUBLIC WORKS  
SEWER DIVISION

Sketch of Service Here

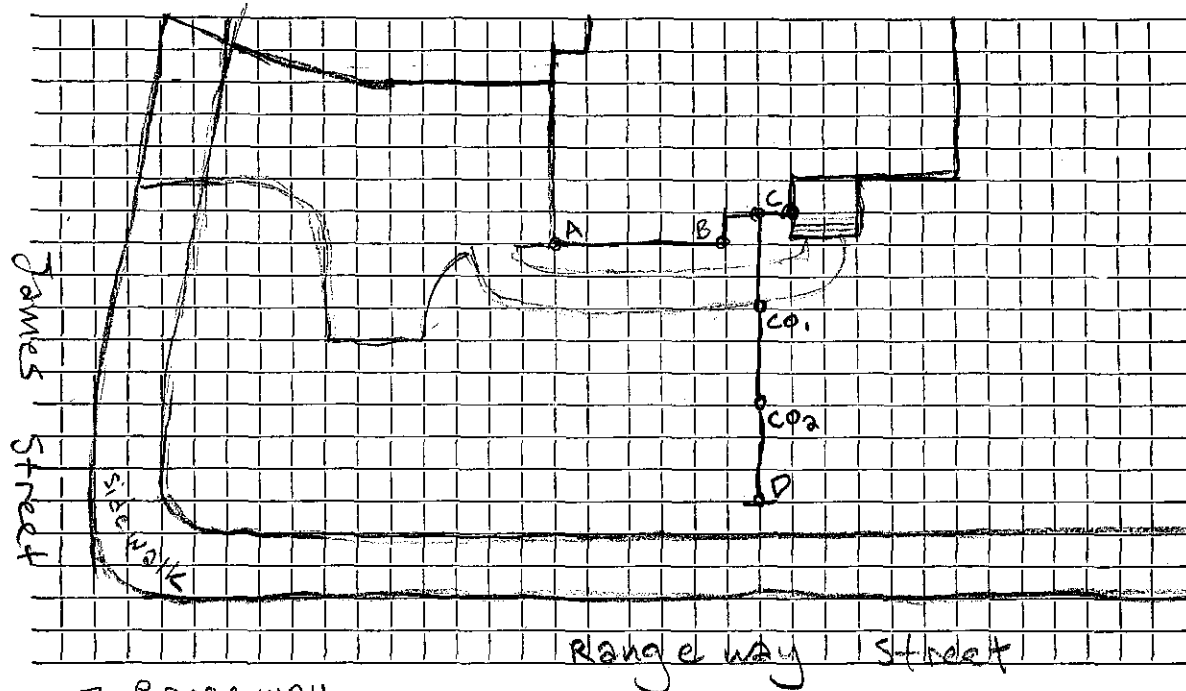

- 6" SDR
- 2 clean outs,  
Drops at retaining wall.
- A-CO<sub>1</sub> = 31'
- C-CO<sub>1</sub> = 23'
- A-CO<sub>2</sub> = 39'
- C-CO<sub>2</sub> = 38.5'
- AD = 47'
- CD = 53'

Connection made in 7 Range way Street. Work completed .....

Remarks: .....