

Name

Service No.

Address 15 Rawson Avenue

15 Rawson Ave.

Location

Kind of Pipe

Size 6"

Size of Main 8"

Repair—Renewal—New Service

Location


Date	Material	Amount	Total	Date	Amount
5/5/83	1 6" Fernco Adapter				
5/12/83	11' x 21' Patch			4-26-71	
7-21-61	16' 6" Transite			10' 6" Transite	
				1 6"-90° Elbow	
11-6-62	40' 6" Transite			1 6" Adapter	
	1 6"-11¼° Elbow			3-26-79	
				1 6"X1' Transite Nipple	
				1 6"X2' "	
				1 6" Adapter	
				1-29-79	Letter Sent
				1-16-79	Solids 50' out
				1-5-79	Block 20' out

DATE _____

TOWN OF LEXINGTON — BOARD OF PUBLIC WORKS
SEWER DIVISION

Sketch of Service Here

15

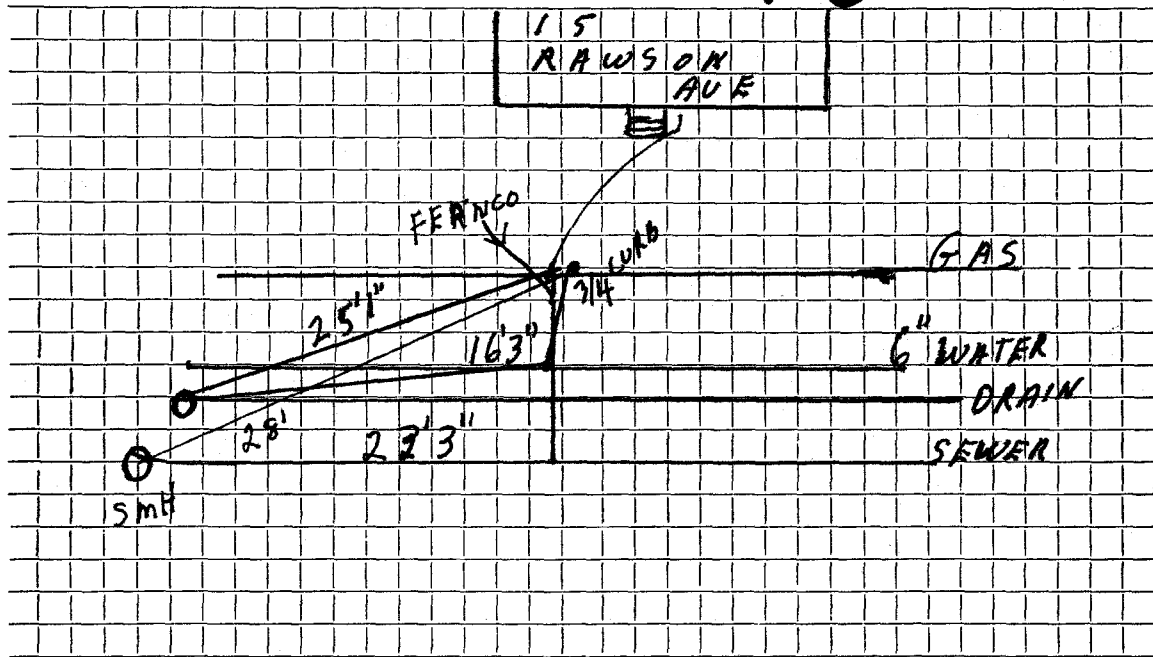

Connection made in Street. Work completed

Remarks:

.....
.....