




DATE June 2020

TOWN OF LEXINGTON — BOARD OF PUBLIC WORKS  
SEWER DIVISION

Sketch of Service Here

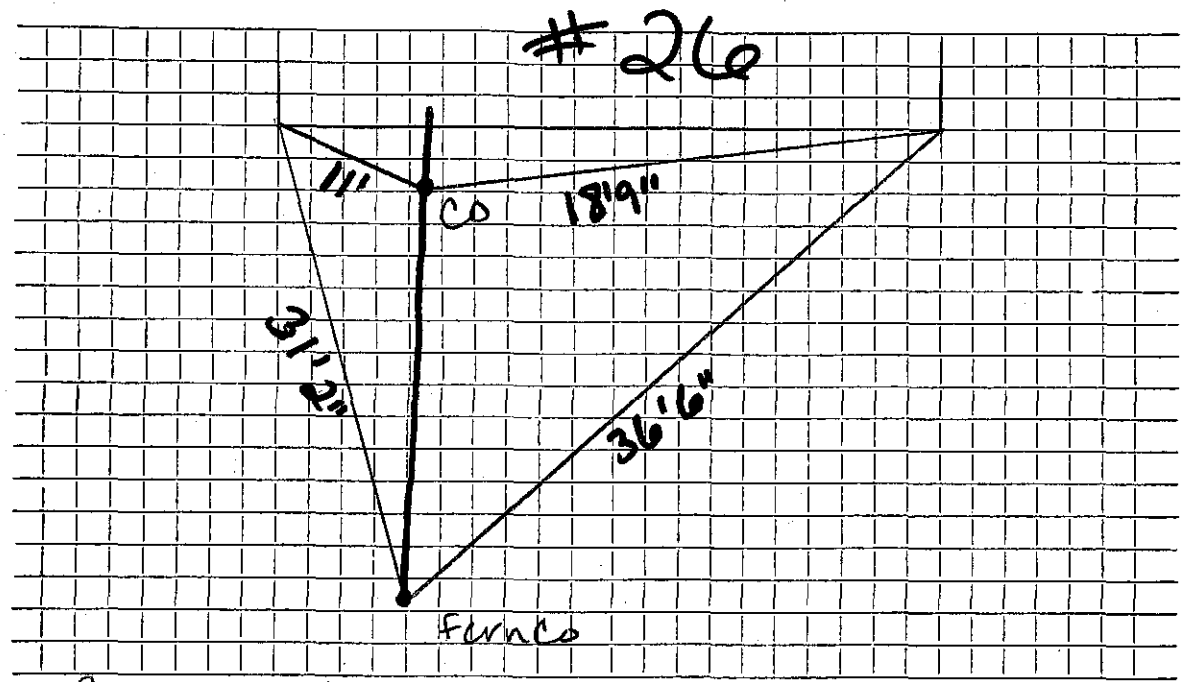

Connection made in ... Rawson Ave ... Street. Work completed .....

Remarks: ... CO depth = 4' ... Furnco depth @ stub = 5'4" ...