




DATE \_\_\_\_\_

TOWN OF LEXINGTON — BOARD OF PUBLIC WORKS  
SEWER DIVISION

Sketch of Service Here

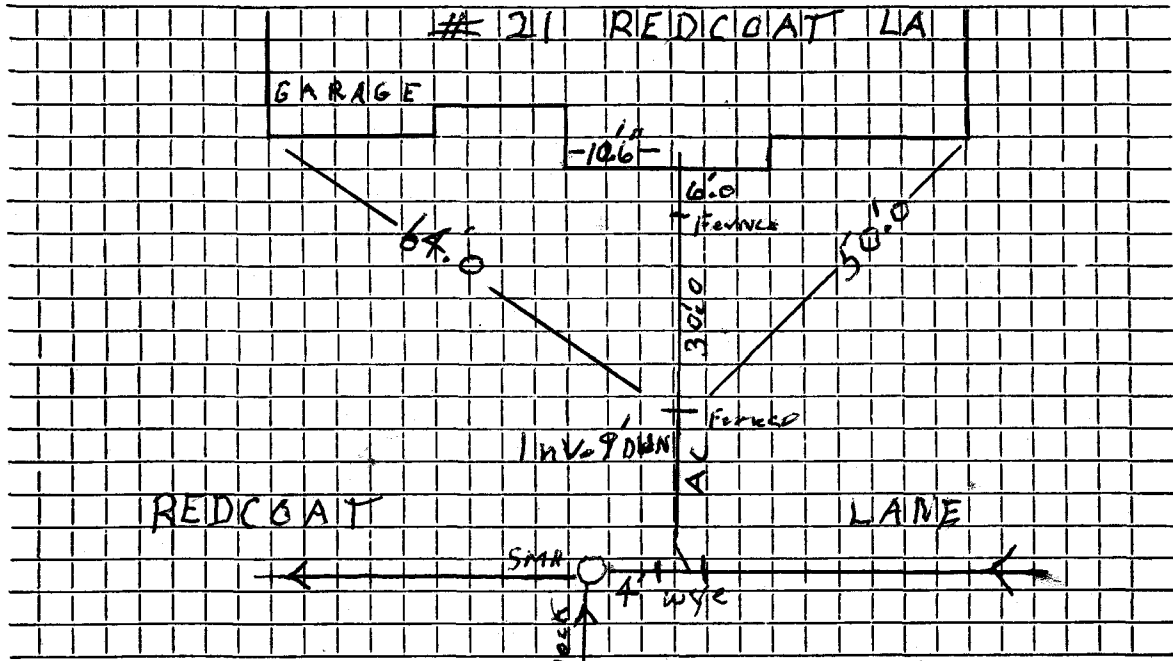

Connection made in ..... Street. 8" Work completed 9/13/06 J.M. Laughlin.....

Remarks: .....

.....

.....