


DATE 1965

TOWN OF LEXINGTON — BOARD OF PUBLIC WORKS
SEWER DIVISION

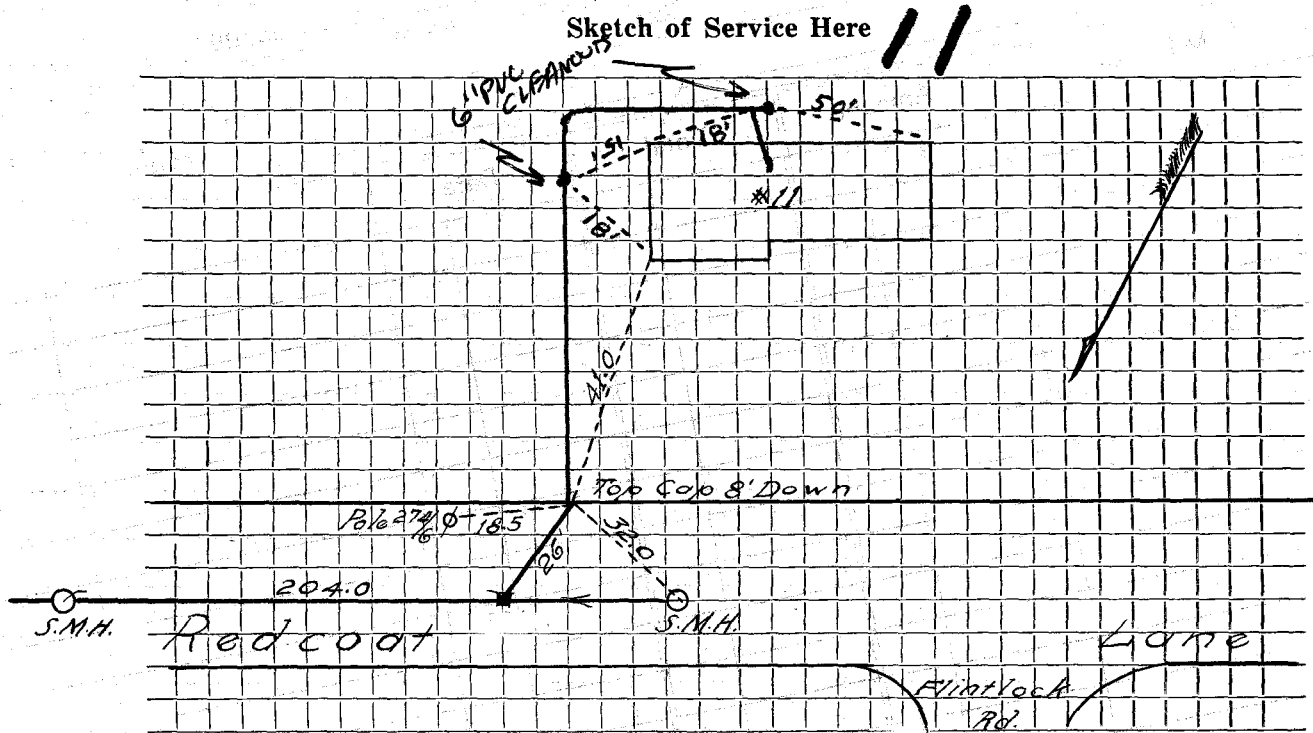

Connection made in Redcoat Street. Work completed .. MAY 1986 ..

Remarks: ..
.....
.....