

Name H. Gordon Buchanan

Service No. 40

Address 15 Red Coat Lane

15 Red Coat Lane

Location

Kind of Pipe

Size 6"

Size of Main 8"

Repair—Renewal—New Service

Kirkland And Shaw #2512


Location AUG 16 1976

Date		Material	Amount	Total	Date	Amount
1965	26'	6" Transite pipe @6.00		156.00	6/20/74	Deposit
		200 @ 6	156			
6/20/74	25'	6" Transite Pipe				
	10'	4" Cast Iron Pipe				

DATE \_\_\_\_\_

TOWN OF LEXINGTON — BOARD OF PUBLIC WORKS  
SEWER DIVISION

Sketch of Service Here **15**

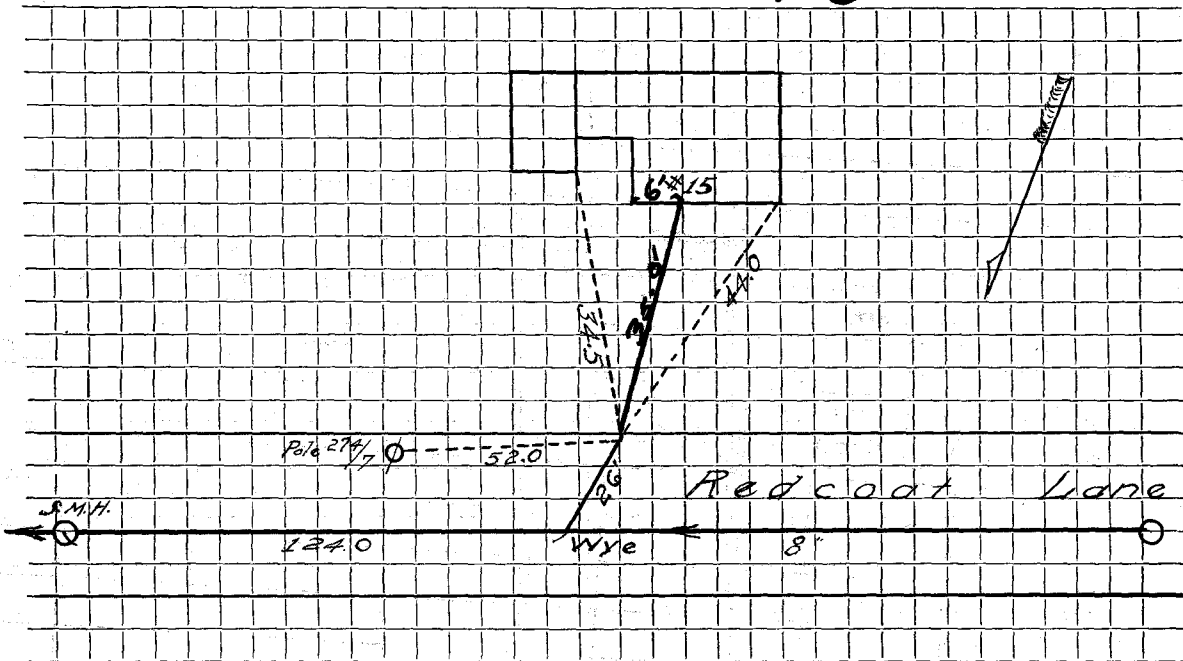

Connection made in **#15 Redcoat Lane** Street. Work completed **6/20/74**

Remarks: .....

.....

.....