

Name Philip Boyd

Service No. 123

Address 16 Redcoat Lane

16 Red Coat Lane

Location

Kind of Pipe

Size 6"

Size of Main 8"

~~Repair - Renewal~~ New Service Suburbanite #A434


Location NOV 7 1966

Date	Material	Amount	Total	Date	Amount
1965	16' 6" Transite pipe @6.00		96.00	9-26-66	96.00
9/30/66	36' 6" Transite pipe				
	10' 4" Cast Iron pipe				

DATE _____

TOWN OF LEXINGTON — BOARD OF PUBLIC WORKS
SEWER DIVISION

Sketch of Service Here **16**

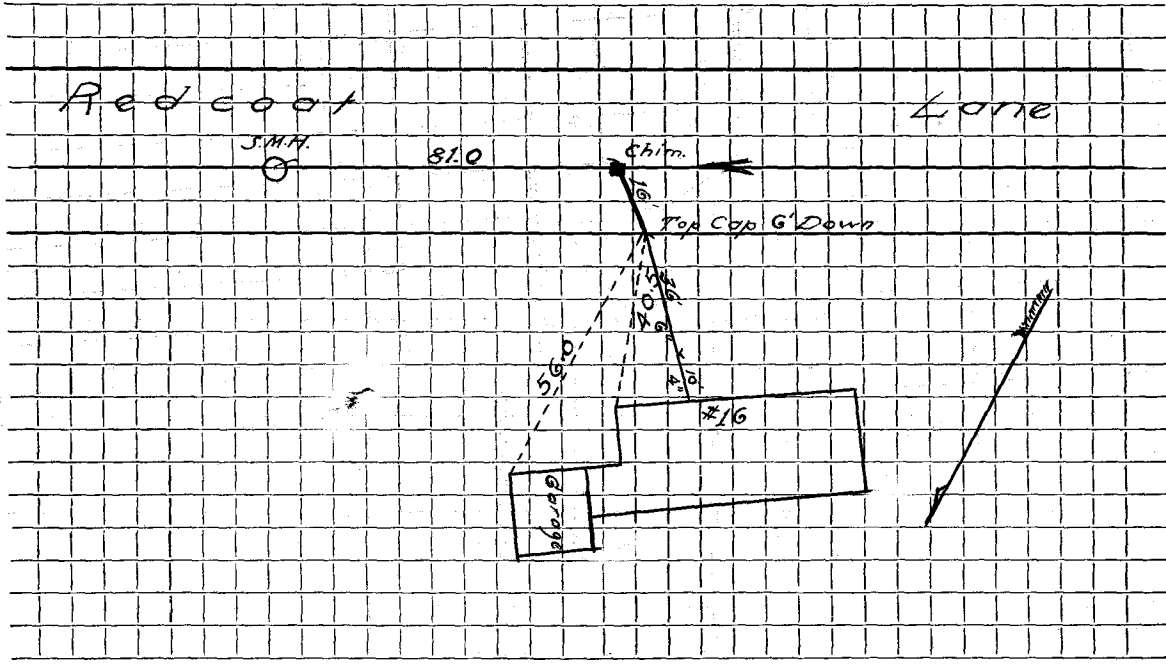

Connection made in Street. Work completed

Remarks:
.....
.....