


DATE 4/2018

TOWN OF LEXINGTON — BOARD OF PUBLIC WORKS
SEWER DIVISION

Sketch of Service Here

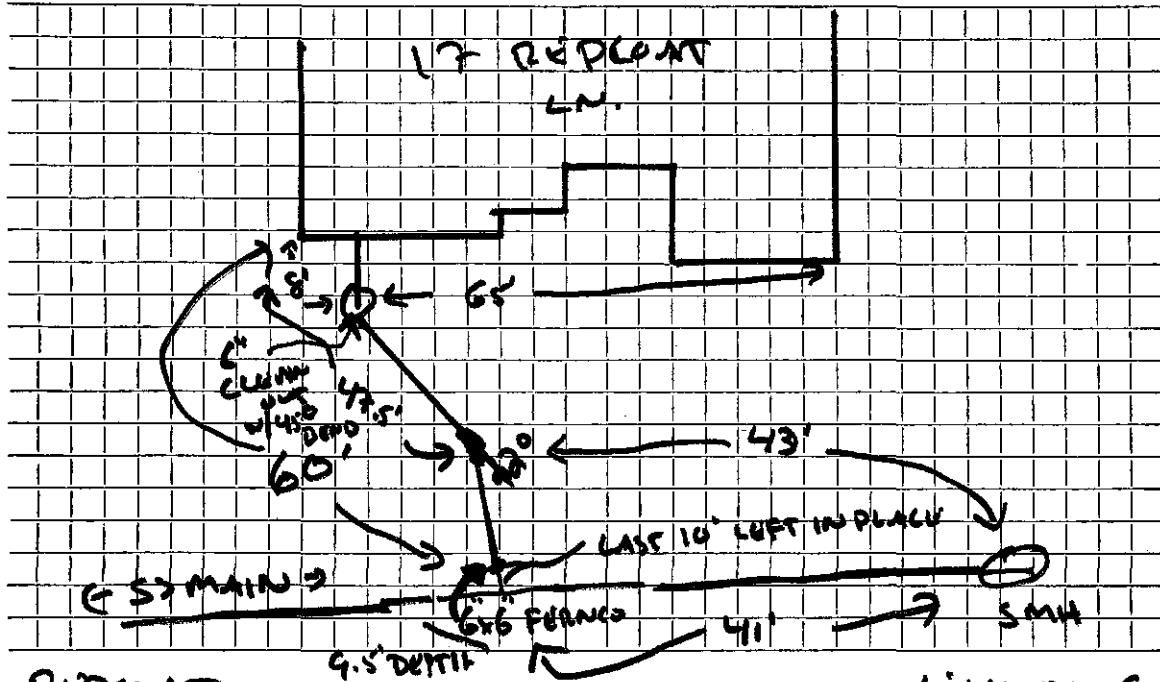

Connection made in Redclay Street. Work completed E. YOUNG CONSTRUCTION

Remarks:

.....

.....