


DATE _____

TOWN OF LEXINGTON — BOARD OF PUBLIC WORKS
SEWER DIVISION

Sketch of Service Here

6

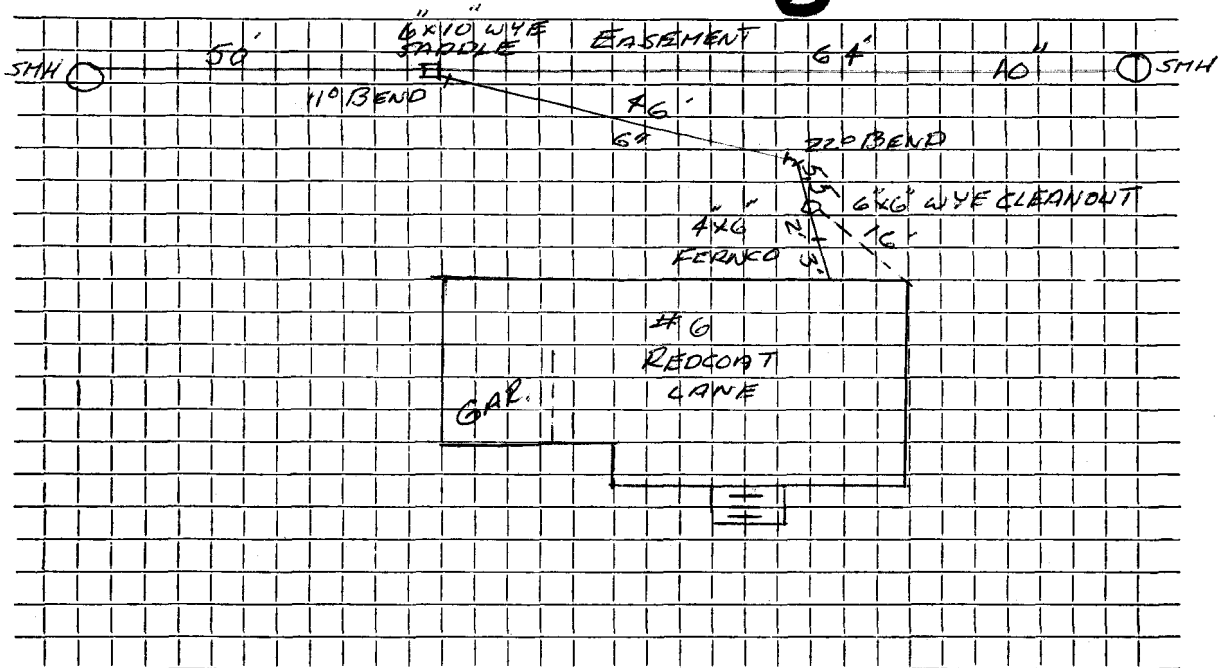

Connection made in EASEMENT Street. Work completed

Remarks: Original Service 12-53

.....
.....