

Name Wallace G. Ewisinger

Service No. 64

Address 101 REED ST.

101 Reed Street

Location

Kind of Pipe

Size 6"

Size of Main 8"

Repair—Renewal—New Service

W.O.#4871 Old Excav. #671


Location MAR 18 1968

Date	Material	Amount	Total	Date	Amount
6-13-67	117' 6" Transite pipe			4-14-68	Deposit 100 00
	10' 4" Cast Iron pipe			3-18-68	Return 43 24
					56 76
6/15/67	Labor	12.10			
6/22/67	Labor	12.26	24 36		
	10% O.H.	2 44	26 80		
	14' 6" transite pipe @.88		12 32		
	1 elbow		4 09		
	1 ton hot top		5 80		
	1/2 hr. shovel @6.50		3 25		
	1 hr. trucking @3.00		3 00		
	1/2 hr. roller @3.00		1 50		
	Labor		56 76		

DATE _____

TOWN OF LEXINGTON — BOARD OF PUBLIC WORKS
SEWER DIVISION

Sketch of Service Here

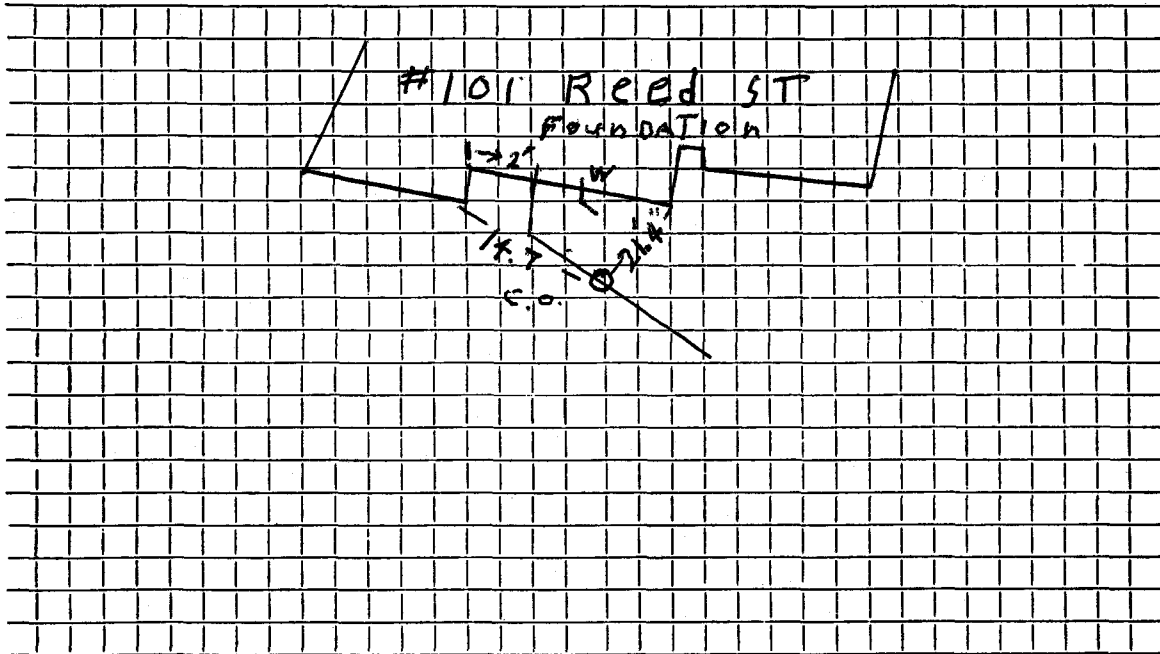

Connection made in Street. Work completed

Remarks:
.....
.....