

Name Mrs. A. Sgrosso

Service No. 189

Address 104 Reed Street ST.

104 Reed Street

Location

Kind of Pipe

Size 6"

Size of Main 8"

~~Renewal~~ New Service

Location Comm 3-16-59

Date	Material	Amount	Total	Date	Amount
1-4-58	Labor	64.06		10-30-58	225.00
1-5-58	"	59.41	123.47	3-30-59	30.36
	10% O.H.		12.35		355.36
& 70'	6" Transite pipe @.70		49.00		NON CHARGE
1	6" 90° Elbow		5.29	11-4-58	Labor 16.03
24	x 3 Patch		24.00		2 hrs. Town Shovel @6.50 13.00
6	hrs. Town Shovel @6.50		39.00		29.03
3	hrs. Trucking @.75		2.25		
			255.36		
	Labor			3-24-59	Respond and Measure
				Bill sent 3-16-59	30.36

# TOWN OF LEXINGTON—DEPT. OF PUBLIC WORKS

## SEWER DIVISION

DATE.....

NO. ....


The undersigned applies for the construction of a particular sewer connecting No..... Street and hereby agrees to comply with the Rules and Regulations governing the construction and use of Particular Sewers, as now or at any future time established by the Board of Selectmen.

Am't of estimate \$.....

Am't Paid \$.....

..... Owner

Sketch of Service Here **104**

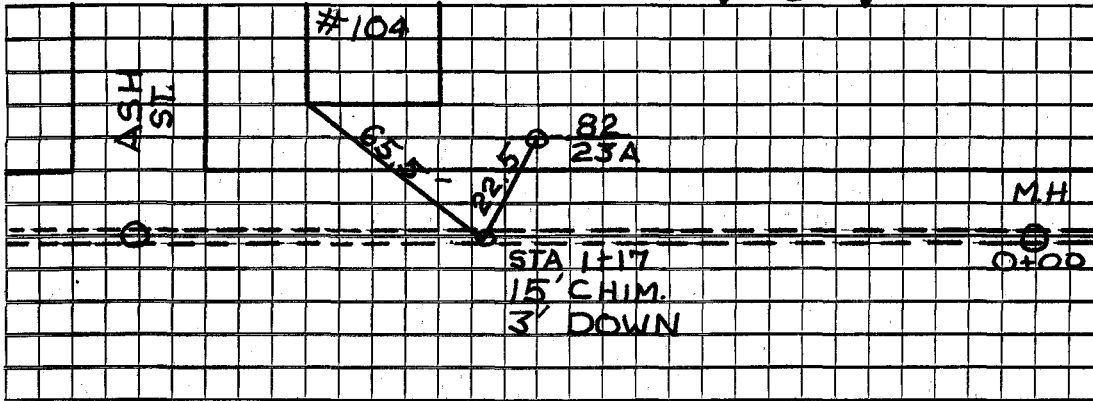

Connection made in..... Street.

Work completed.....19..

Remarks: