

Name William Noz

Service No. 46 *V 711 P*

Address 108 REED ST.

TOWN ERROR

Location

Kind of Pipe

Size 6"

Size of Main 8"

Repair—Renewal—New Service W.O. #6383 Craftsman #1368

Location JUL 7 1969

Date	Material	Amount	Total	Date	Amount
	<b>NON-CHARGE</b>				
6/11/69	Labor	29 26		5-28-69	Deposit
6/20/69	"	28 12	57 38	7-7-69	Returned (Town Error)
	20' 6" Transite pipe .88		17 60	8-5-69	Paid
	1 90o Elbow		4 09		
	1 Plug		1 93		
	1 Hr. Trucking		3 00		
	1 " "		1 50		
	1/2 " Compressor 5.00		2 50		
	1 1/2 " Shovel @ 4.00		6 00		
	1/2 " Roller @ 3.00		1 50		
	Trailer		2 00		
	<b>Labor</b>		<b>97 50</b>		
6-19-69	67' 6" Transite pipe				
	56' 4" Cast Iron pipe				

# TOWN OF LEXINGTON—DEPT. OF PUBLIC WORKS

## SEWER DIVISION

DATE.....


NO.....

The undersigned applies for the construction of a particular sewer connecting No..... Street and hereby agrees to comply with the Rules and Regulations governing the construction and use of Particular Sewers, as now or at any future time established by the Board of Selectmen.


Am't of estimate \$.....

Am't Paid \$.....

..... Owner

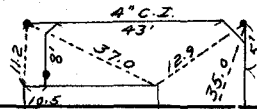

Sketch of Service Here **108**

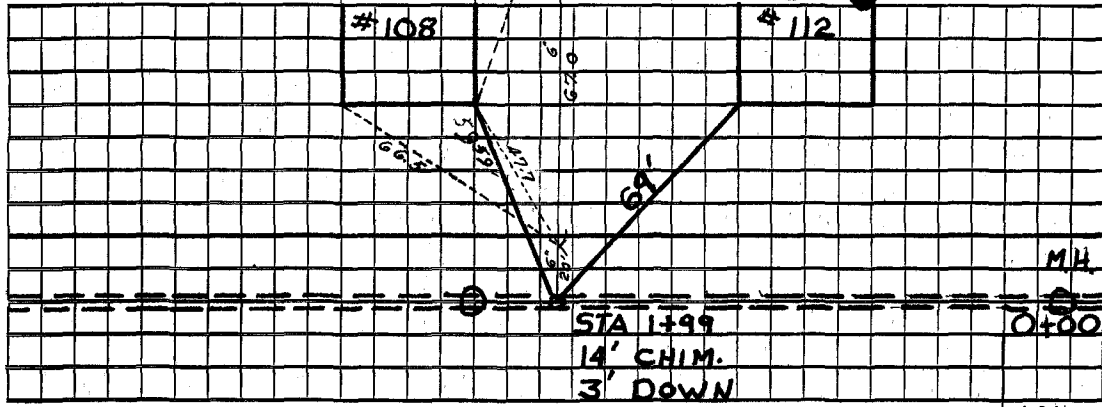

Connection made in..... Street.

Work completed..... 19..

Remarks:

ASH.  
S.T.