


TOWN OF LEXINGTON — BOARD OF PUBLIC WORKS


* lowered Sewer in street only 2 feet deep.

7/15/11 / Lot 18 2
Pg 72 58

Sewer

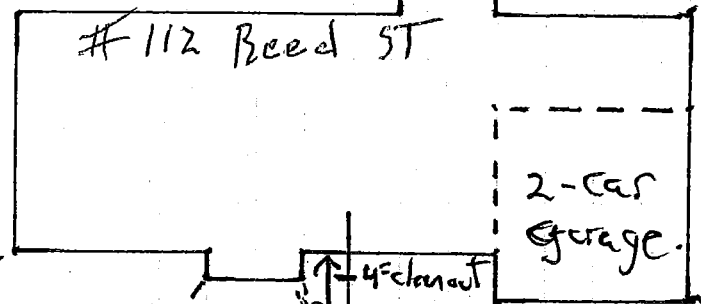

house to cleanout	2'-0"	4
Clean out to 4x6"	5'-0"	4
4x6" to 22° bend	5'-8"	6
22° bend to stub	43'-0"	6
total	55'-8"	

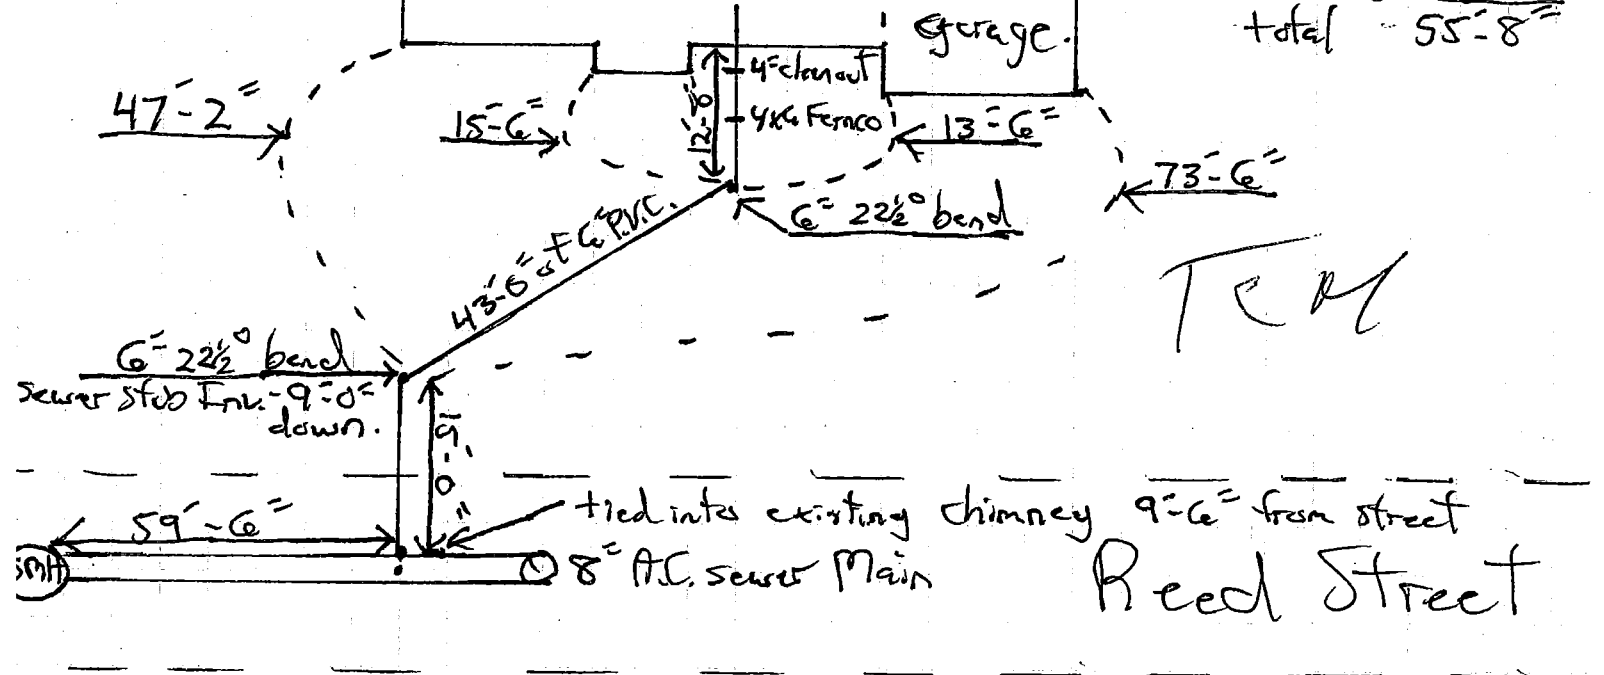

TRM

tied into existing chimney 9'-6" from street

Reed Street

Con
Rer
...