


DATE _____

TOWN OF LEXINGTON — BOARD OF PUBLIC WORKS
SEWER DIVISION

Sketch of Service Here
12 ~~MANA~~ REED ST. 12

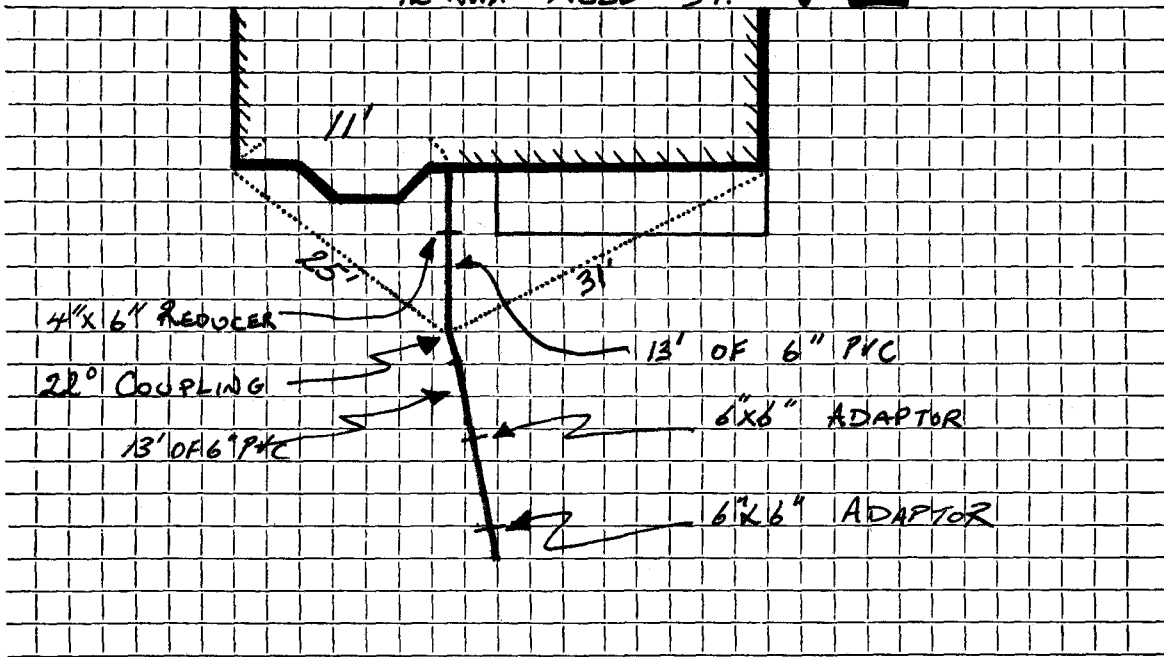

Connection made in REED Street. Work completed

Remarks: INSIDE YARD AREA PIPE IS 5' DOWN

INSIDE WALK AREA PIPE IS 4' DOWN

Original Service 9-13-48 (60'-6" Sewer Pipe)