

Name L. H. Hewett Jr., Inc.

Service No. 86

Address 120 Reed Street

120 Reed Street

Location

Kind of Pipe

Size 6"

Size of Main 8"

~~Repair~~ New Service Hewett #3491 W.O. #849

Location JUL 7 1980

Date	Material	Amount	Total	Date	Amount
11-30-79	Labor	105.72		11-30-79	315.00
	10% O.H.	10.57	116.29	7-7-80	48.57
20'	6" Transite pipe @1.62		32.40		266.43
1	6" x 2' Nipple		7.60		
1	6" x 6" Nipple		1.93		
1	6" x 90° Elbow		6.21		
½	bag Cement		2.30		
6	Brick @.12		.72		
2	hrs. Trucking @3.00		6.00		
2	hrs. Backhoe @ 6.50		13.00		
	Hot Top 10' x 12'		79.98		
			266.43		
12-28-79	47' 6" Transite pipe				
	10' 4" Cast Iron pipe				


DATE \_\_\_\_\_

TOWN OF LEXINGTON — BOARD OF PUBLIC WORKS

SEWER DIVISION

Sketch of Service Here

120

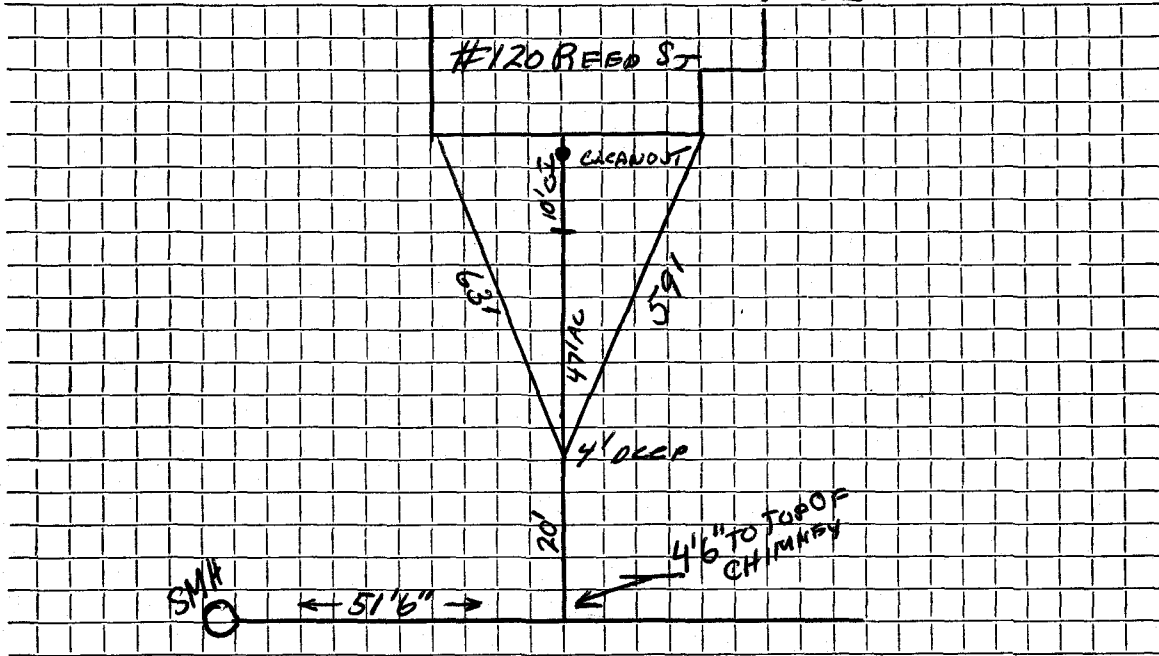

Connection made in ..... Street. Work completed .....

Remarks: .....

.....

.....