

Name Maria A. Badaracco

Service No. 60

Address 13 Reed Street

13 Reed ST.

Location

Kind of Pipe

Size 6"

Size of Main 8"

Repair—Renewal—New Service W.O.#4829 Eagle #652

Location MAR 18 1968

Date		Material	Amount		Total		Date	Amount
6-19-67	36'	6" Transite pipe					6-19-67	125 00
							3/26/68	37 81
6/13/67		Labor	60.88					162 81
6/22/67		Labor	20.88					
6/22/67		Labor	16.98	98	74			
		10% O.H.		9	87	108	61	
	20'	6" transitepipe @.88			17	60		
	1	plug			3	80		
	1	ton hot top			5	80		
	2	hrs. shovel @6.50			13	00		
	2	hrs. trucking @3.00			6	00		
	1	hr. compressor @5.00			5	00		
	1	hr. roller @3.00			3	00		
					162	81		
								Bill sum 37.81


DATE _____

TOWN OF LEXINGTON — BOARD OF PUBLIC WORKS

SEWER DIVISION

Sketch of Service Here

13

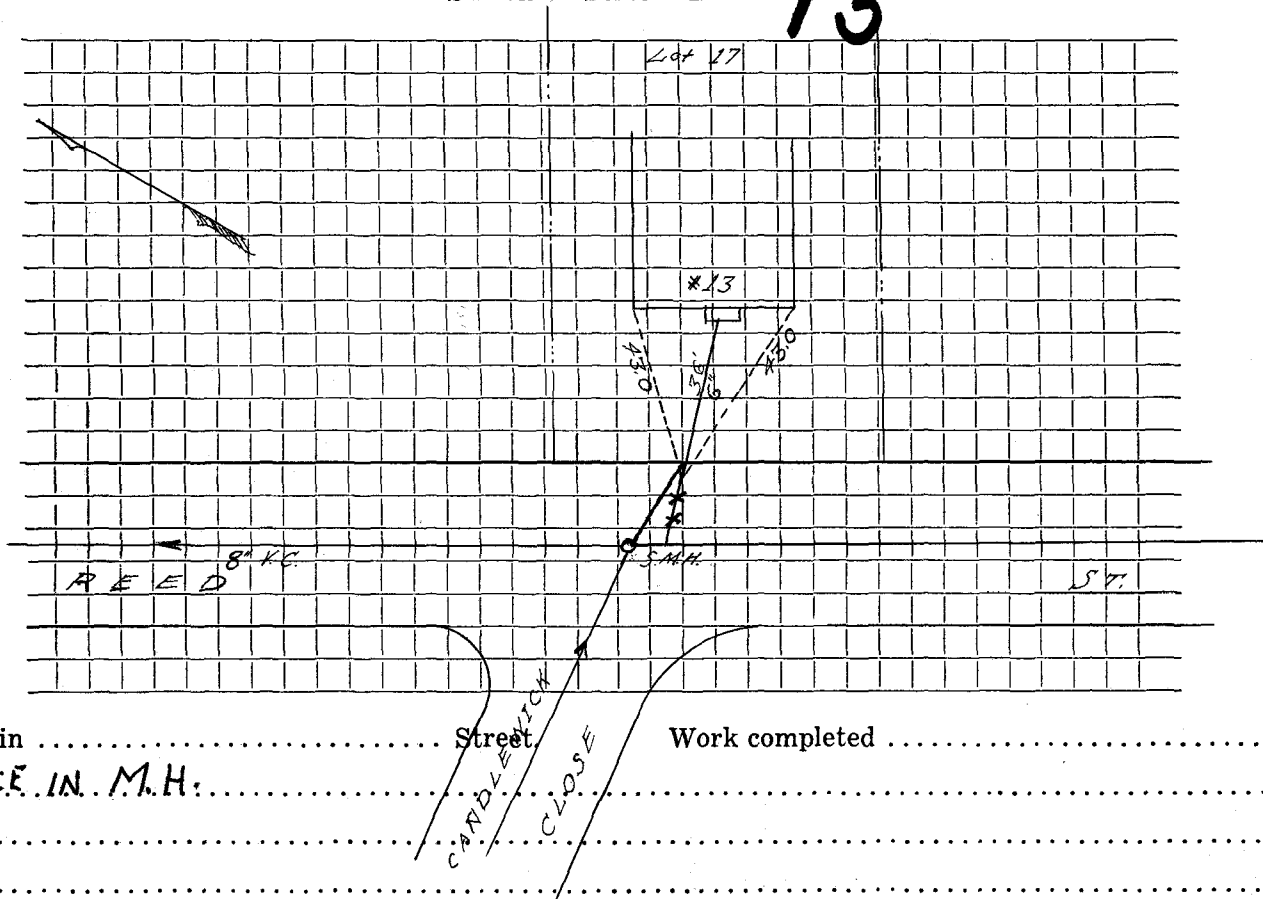

Connection made in Street Work completed

Remarks: SERVICE IN M.H.

.....

.....