

Name Carl P. Stone

Service No. 197

Address 133 Reed Street

133 Reed Street

Location

Kind of Pipe

Size 6"

Size of Main 8"

Repair/Replacement - New Service

WC # 2014

Location Comm 2-26-62

Date	Material	Amount	Total	Date	Amount
1/16/62	Labor	76 79		12-21-61	200 00
	10% O.H.	7 68	84 47	2-26-62	33 93
	42' 6" Transite Pipe @ .78		32 76		166 07
	1 11 1/4° Transite Bend		5 10		
	1 22 1/2° Transite Elbow		2 24		
	13 K 3 Patch		13 00		
	3 Hrs. Town Shovel @ 6.50		19 50		
	2 Hrs. Trucking @ 3.00		6 00		
	1 Hr. Trojan Loader @ 3.00		3 00		
			166 07		
	Labor				

TOWN OF LEXINGTON—DEPT. OF PUBLIC WORKS

SEWER DIVISION

DATE.....

NO.....


The undersigned applies for the construction of a particular sewer connecting No..... Street and hereby agrees to comply with the Rules and Regulations governing the construction and use of Particular Sewers, as now or at any future time established by the Board of Selectmen.

Am't of estimate \$.....

Am't Paid \$.....

..... Owner

Sketch of Service Here

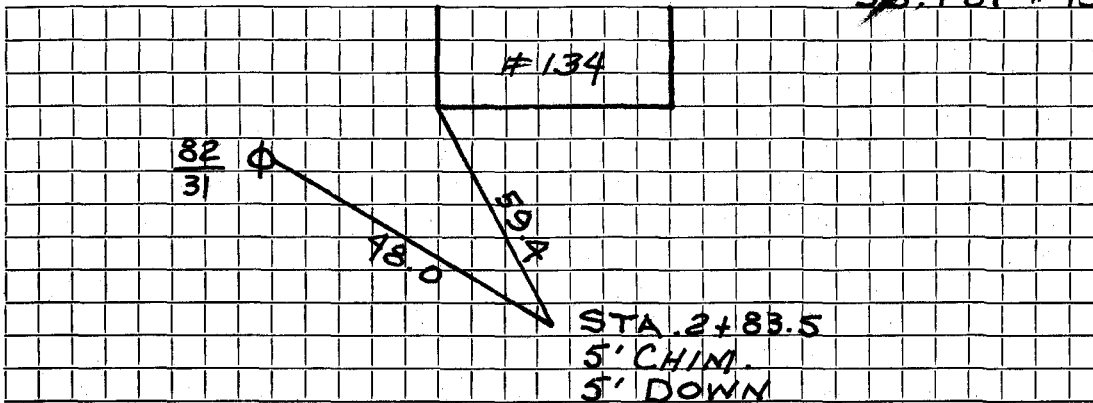

Connection made in..... Street.

Work completed.....19..

Remarks: