

Name Osgood Bros.

Service No. 43

Address 137 Reed Street

137 Reed Street

Location

Kind of Pipe

Size 6"

Size of Main 8"

Repair/ Renewal — New Service DeFelice #3003 W.O. #5585

Location AUG 29 1977


Date	Material	Amount	Total	Date	Amount
7/19/77	labor	77. 22		7/8/77	Deposit 350.00
	10%OH	7. 72	84. 94	8/29/77	Refund 92. 28
10'	6" transite pipe @ 1.51		15. 10		257. 72
1	5' X 6" nipple @ 1.76		8. 80		
2	6" X 22½° bends @ 9.60		19. 20		
2	hrs. trucking @ 3.00		6. 00		
1	hr. loader @ 4.00		4. 00		
2	hrs. shovel @ 6.50		13. 00		
	Hot Top 20' X 8'		106. 68		
			257. 72		
6/26/77	68' 6" transite pipe				
	10' 4" clay pipe				

DATE _____

TOWN OF LEXINGTON — BOARD OF PUBLIC WORKS
SEWER DIVISION

Sketch of Service Here

137

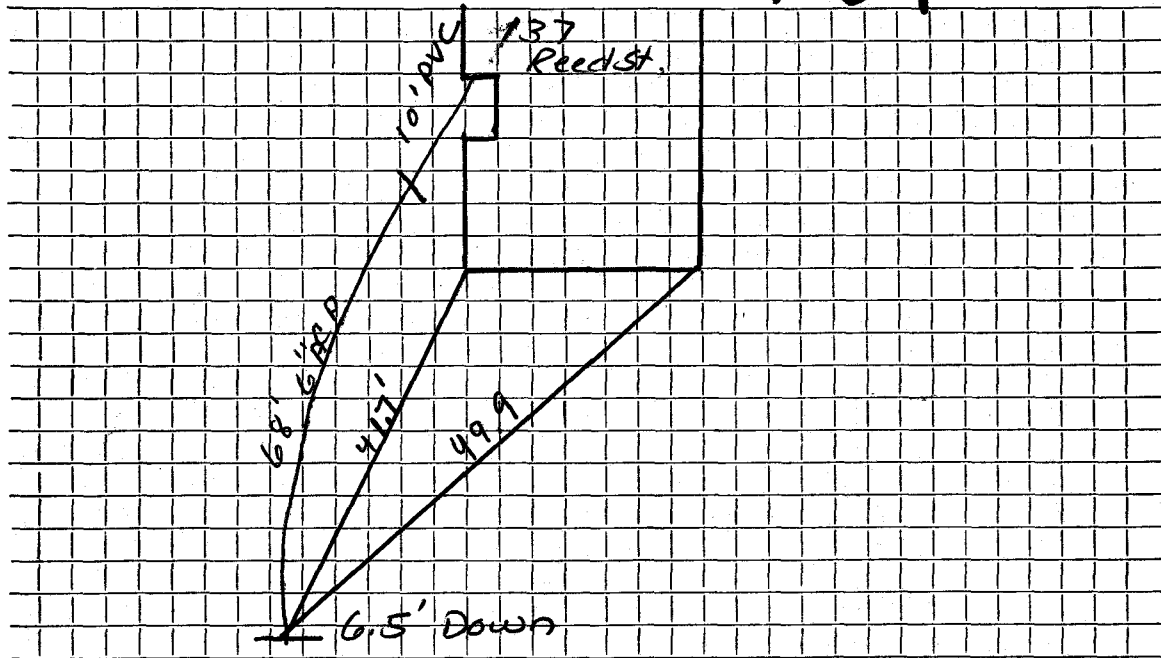

Connection made in Street. Work completed

Remarks:
.....
.....