

Name Tricorn Homes

Service No. 89

Address 138 Reed Street

138 Reed Street

Location BLOCK 18 LOT 1

Kind of Pipe

Size 6"

Size of Main 8"

~~Repair Work~~ New Service W.O. #8759 Russell Sibley Permit #12

Location Cinn 9-21-64

Date	Material	Amount	Total	Date		Amount
6-16-64	Labor	55.14		5-15-64	Deposit	100.00
	10% O.H.	5.51	60.65	9-21-64	Paid by W/H #51	1.66
	10' 6" Transite pipe @32		8.20	10-15-64	Paid	2.47
	1 bag Cement		1.50			<u>104.13</u>
	1 11 1/4" Transite Elbow		2.35			
	1 6" Transite Plug		1.72			
	1 12" Transite Nipple		1.21			
	11 x 3 Patch		12.00			
	1 hr. Town Shovel @6.50		6.50			
	2 hrs. Trucking @3.00		6.00			
	1 hr. Loader @4.00		4.00			
			<u>104.13</u>			
	<b>Labor</b>					
6-30-64	19' 6" Transite pipe					
					<i>Bill sent</i>	<i>2.47</i>

**TOWN OF LEXINGTON—DEPT. OF PUBLIC WORKS  
SEWER DIVISION**

DATE.....


NO. ....

The undersigned applies for the construction of a particular sewer connecting No.....  
Street and hereby agrees to comply with the Rules and Regulations governing the construction and use of Particular  
Sewers, as now or at any future time established by the Board of Selectmen.

Am't of estimate \$.....

Am't Paid \$.....

..... Owner

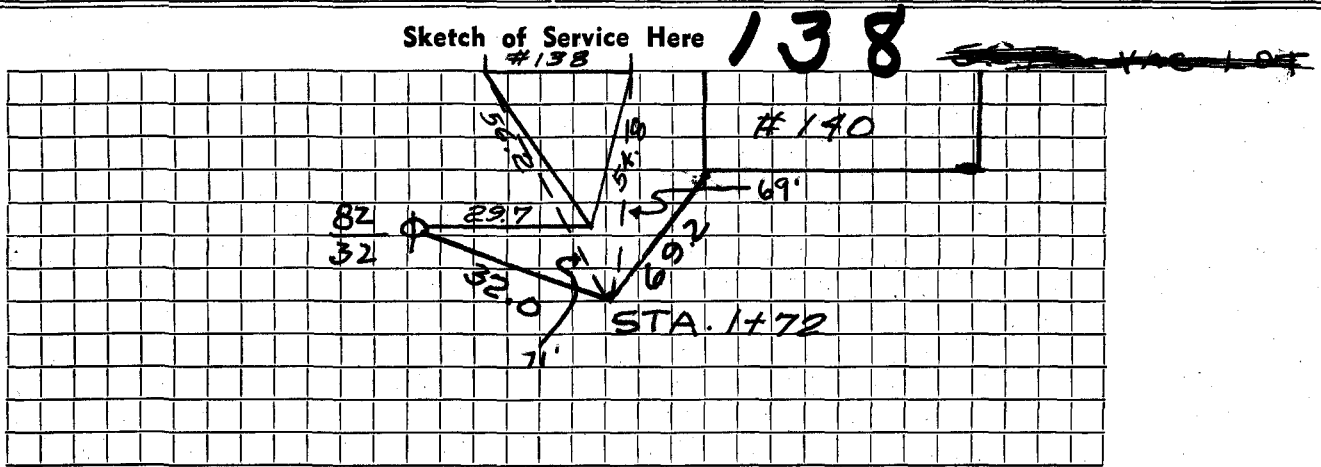

Connection made in..... Street.

Work completed.....19..

Remarks: