

Name Clifford W. Brooks

Service No. 194

Address 140 Reed Street

140 Reed Street

Location

Kind of Pipe

Size 6"

Size of Main 8"

~~Repair~~ New Service

Location Comm 3-16-59

Date	Material	Amount	Total	Date		Amount
12-5-58	Labor	51.26		11-3-58	Deposit	125.00
	10% O.H.	5.13	56.39	3-16-59	Retained	52.51
	45' 6" Transite pipe @.70		31.50			122.49
	1 11 1/4" Transite bend		5.10			
	6 x 3 Patch		6.00			
	2 hrs Town Shovel @ 6.50		13.00			
	1 hr. Trucking @3.00		3.00			
	2 hrs. Trucking @.75		1.50			
	1 hr. Rodgers Trailer @ 3.00		3.00			
	1 hr. Trojan loader @ 3.00		3.00			
			<u>122.49</u>			
	Labor					

TOWN OF LEXINGTON—DEPT. OF PUBLIC WORKS

SEWER DIVISION

DATE.....

NO.

The undersigned applies for the construction of a particular sewer connecting No.....
 Street and hereby agrees to comply with the Rules and Regulations governing the construction and use of Particular
 Sewers, as now or at any future time established by the Board of Selectmen.


Am't of estimate \$.....

Am't Paid \$.....

..... Owner

Sketch of Service Here

140

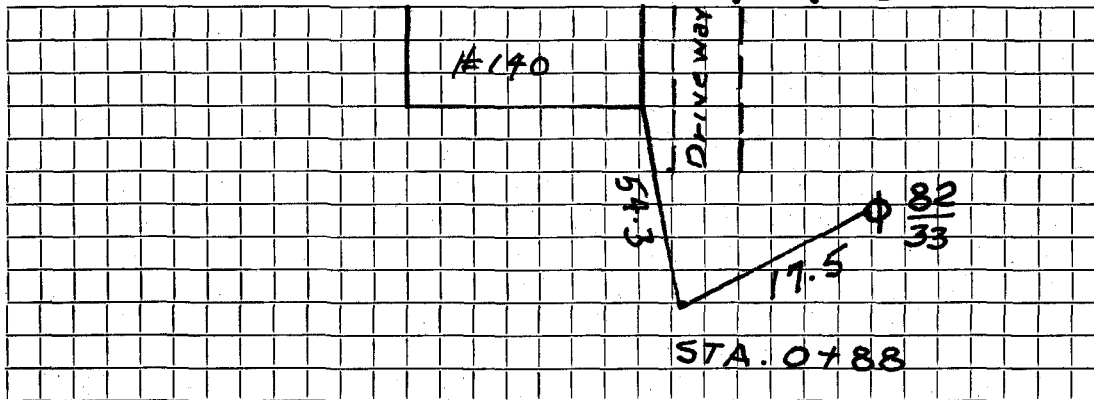

Connection made in..... Street.

Work completed.....19..

Remarks: