

Name Smith Builders

Service No. 35

Address 144 Reed Street

Lot 1

144 Reed Street

Location

Kind of Pipe

Size 6"

Size of Main 8"

~~REPAIR/RENEWAL~~

New Service

R. Kirkland #1378
W. O. # 6306


Location JUL 7 1969

Date	Material	Amount	Total	Date		Amount
5/19/69	Labor	98 34		5-13-69	Deposit	225 00
6/15/69	"	31 06		7-7-69	Retard	6 12
	10% O.H.	12 94	142 34			218 88
	20' Transite pipe .88		17 60			
	1 90o Elbow		4 09			
	2 Ton hot top 5.80		11 60			
	2 " cold patch 5.50		2 75			
	4 Hrs. trucking 3.00		12 00			
	1 " "		1 50			
	2 " shovel 6.50		13 00			
	1 " loader		4 00			
	1 " compressor		5 00			
	1 " roller		3 00			
	Trailer		2 00			
			218 88			
6-10-69	19' 6" Transite pipe					
	10' 4" Cast Iron pipe					

DATE _____

TOWN OF LEXINGTON — BOARD OF PUBLIC WORKS

SEWER DIVISION

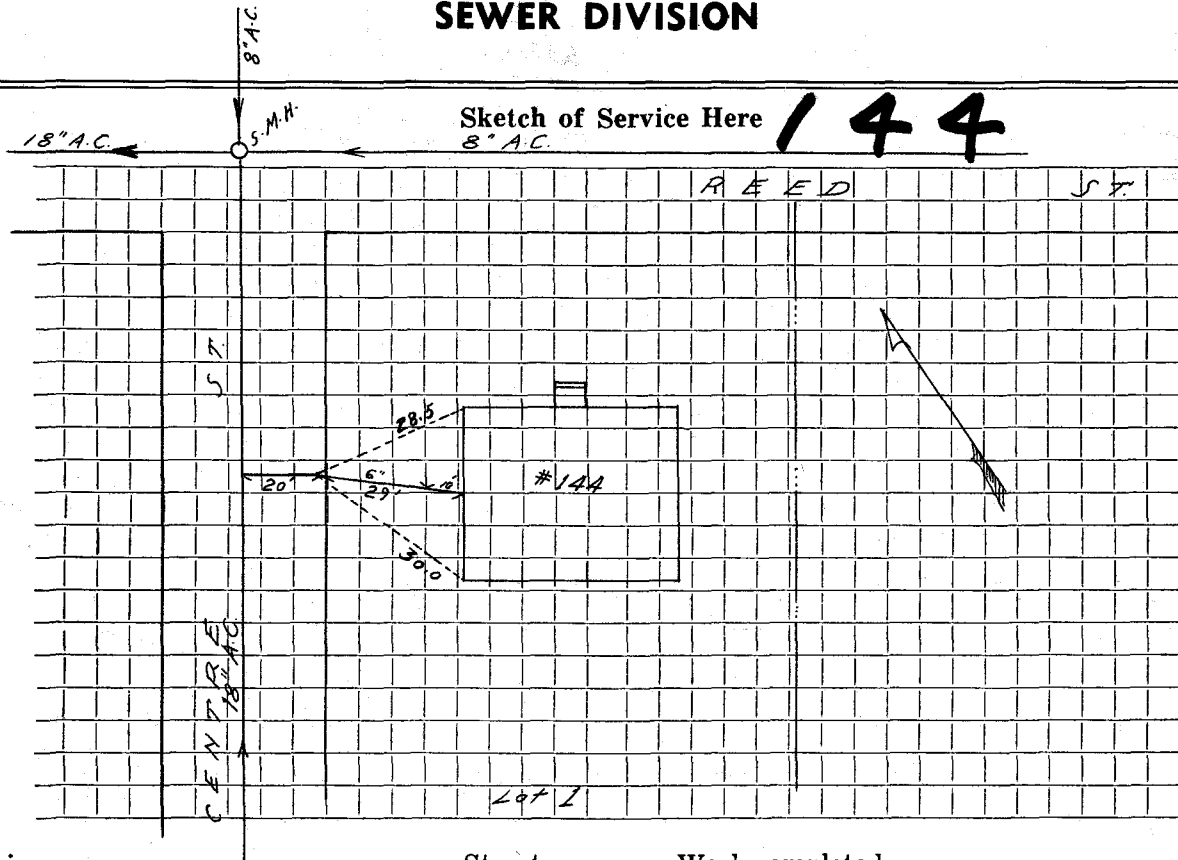

Connection made in Street. Work completed

Remarks:
.....
.....