

Name Robert Shannon

Service No. 128

Address 155 Reed Street

155 Reed Street

Location

Kind of Pipe

Size 6"

Size of Main 8"

~~Repair/ Renewal~~ New Service

W. O. # 8347

Bonnane # 1988

Location APR 26 1972


Date	Material	Amount	Total	Date	Amount
12/16/71	Labor	55 14		12-14-72	Deposit 550 00
	10% O.H.	5 51	60 65	1-22-72	Refund 149 52
25'	6" Transite pipe .90		22 50		100 78
1	6" Cap		1 63		
2	Hrs. Shovel 6.50		13 00		
1	Hr. Trucking		3 00		
			100 78		
1-31-72	26' 6" Transite pipe				
	10' 4" Cast Iron pipe				

DATE \_\_\_\_\_

TOWN OF LEXINGTON — BOARD OF PUBLIC WORKS

SEWER DIVISION

Sketch of Service Here **155**

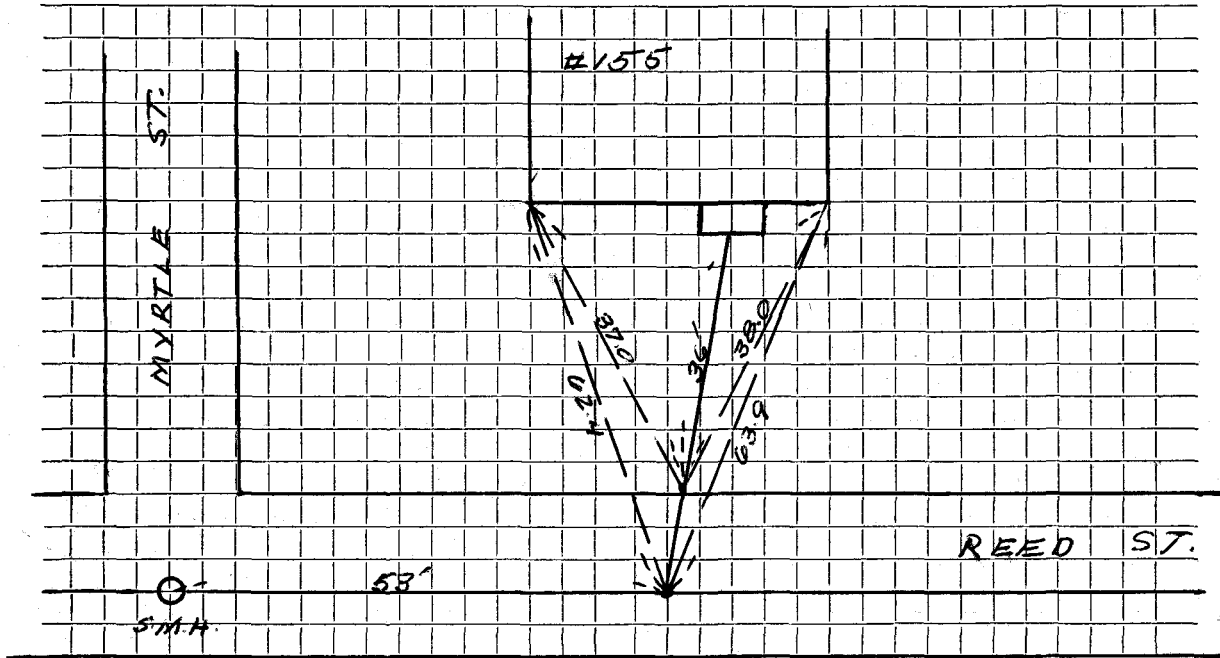

Connection made in ..... Street. Work completed .....

Remarks: .....

.....

.....