

Name **Onel DeFlice, Jr.**

Service No. **136**

Address **156 Reed Street**

**156 Reed Street**

Location

Kind of Pipe

Size **6"**

Size of Main **8"**

~~XXXXXX~~ **New Service**


Location *Comm 8-22-60*

Date	Material	Amount	Total	Date	Amount
7-26-60	Labor	14 11		7-19-60	100.00
7-27-60	"	17 48		8-22-60	5.25
		31 59			94.95
	10% O.H.	3 16	34 75		
	65' 6" Transite pipe @78		50 70		
	1 Hr Town Shovel @6.50		6 50		
	1 Hr Trucking @3.00		3 00		
			94 95		

DATE \_\_\_\_\_

TOWN OF LEXINGTON — BOARD OF PUBLIC WORKS  
SEWER DIVISION

Sketch of Service Here **156**

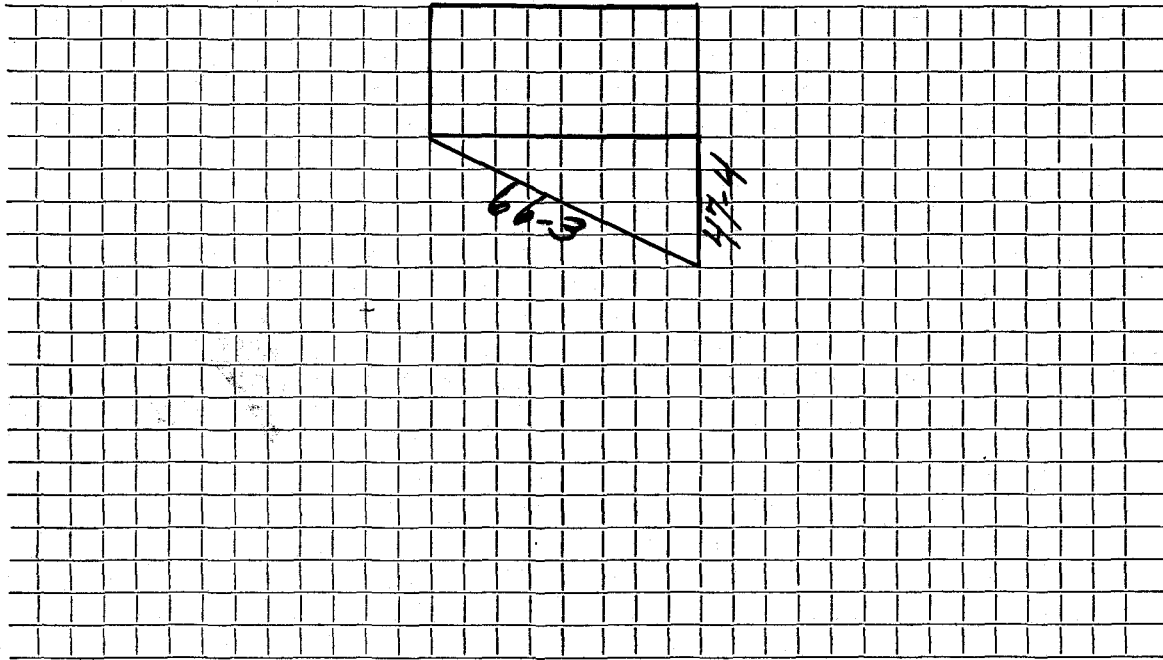

Connection made in ..... Street. Work completed .....

Remarks: .....  
.....  
.....