

Name Joseph Rosetta

Service No. 150

Address 159 Reed St.

159 Reed Street

Location

Kind of Pipe

Size 6"

Size of Main 8"

Repair—Renewal—New Service WO#3698 Kirland and Shaw #2746

Location AUG 16 1976

Date	Material	Amount	Total	Date	Amount
9/8/75	labor	61. 14		9/4/75	Deposit 200. 00
	10%OH	6. 11	67. 25	8/16/76	Refund 89. 76
	10' 6" transite pipe @	1.48	14. 80		110. 24
	1 22½ bend		9. 26		
	1 30 degree El		4. 75		
	1 clay to transit		2. 43		
	1 6" plug		3. 75		
	½ hr. truck @ 3.00		1. 50		
	1 hr. shovel		6. 50		
			110. 24		
9/25/75	13' 6" Transite Pipe				
	10' 4" Cast Iron Pipe				


DATE \_\_\_\_\_

TOWN OF LEXINGTON — BOARD OF PUBLIC WORKS

SEWER DIVISION

Sketch of Service Here

159

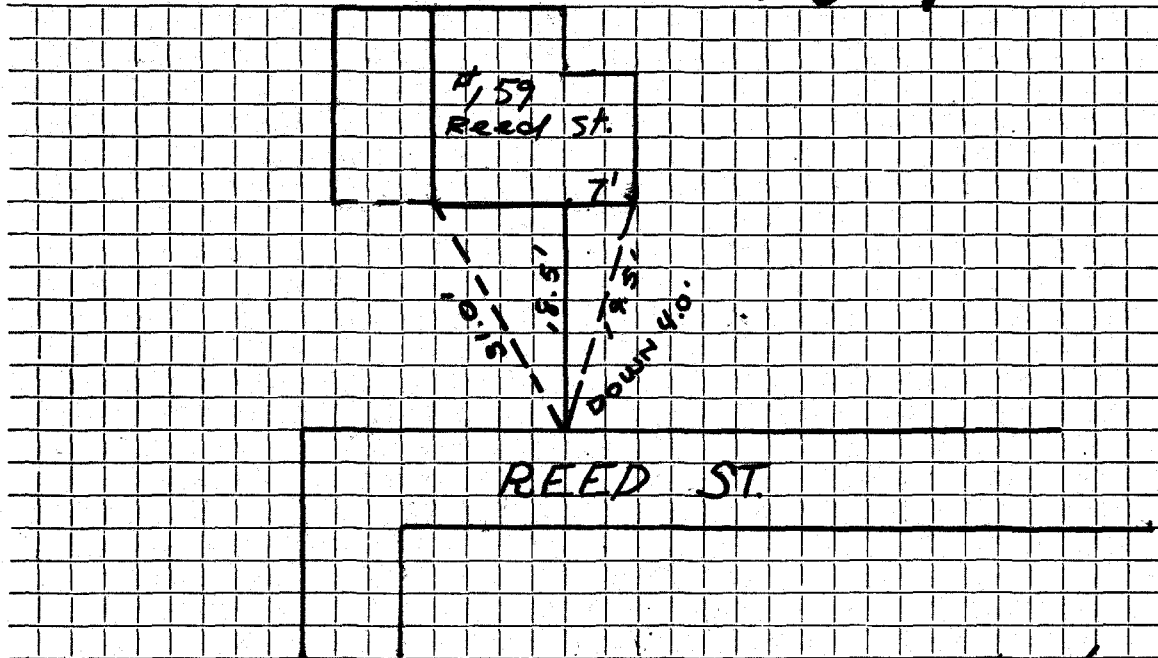

Connection made in 159 Reed St. Street. Work completed 9/25/75

Remarks: .....