




DATE 9/20/94

TOWN OF LEXINGTON — BOARD OF PUBLIC WORKS  
SEWER DIVISION

Sketch of Service Here

19

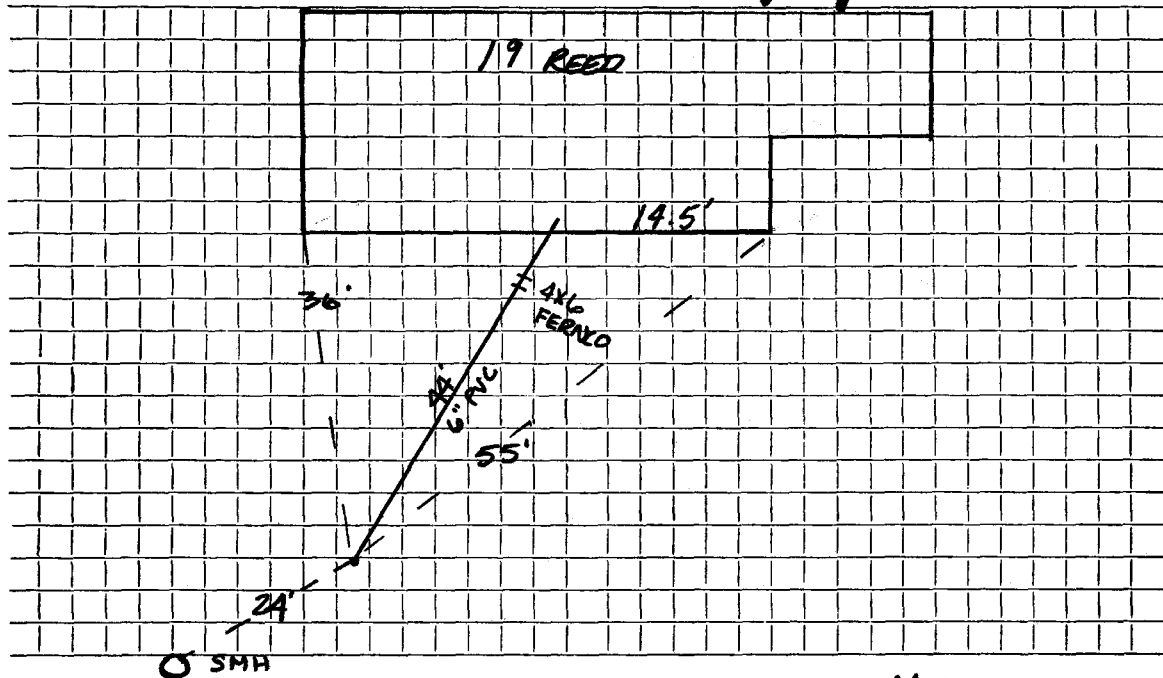

Connection made in REED ST. Street. Work completed MCLAUGHLIN

Remarks: .....

.....

.....