

Name Howard Nason

Service No. 57

Address 23 Reed Street

23 Reed Street

Location

Kind of Pipe

Size 6"

Size of Main 8"

Repair—Renewal—New Service

Location NOV 23 1970


Date	Material	Amount	Total	Date	Amount
7/6/70	Labor		48 23	7-3-70	Deposit 355 00
	10% O.H.		4 82	11-23-70	Refund 161 39
	30' 6" Transite pipe .90		27 00		93 61
	1 22½" Bend		4 09		
	1 Adaptor		2 72		
	1 Donut		25	7/6/70	<u>OUTSIDE</u> Labor 86 83
	1 Yd. Loam		3 50	19'	Transite pipe .90 17 10
	1 Hr. Trucking		3 00	2	11½ ₄₀ Ells 3.56 7 12
			93 61	1	Yd. Loam 3 50
				1	Hr. Trucking 3 00
					117 55

DATE _____

TOWN OF LEXINGTON — BOARD OF PUBLIC WORKS

SEWER DIVISION

Sketch of Service Here

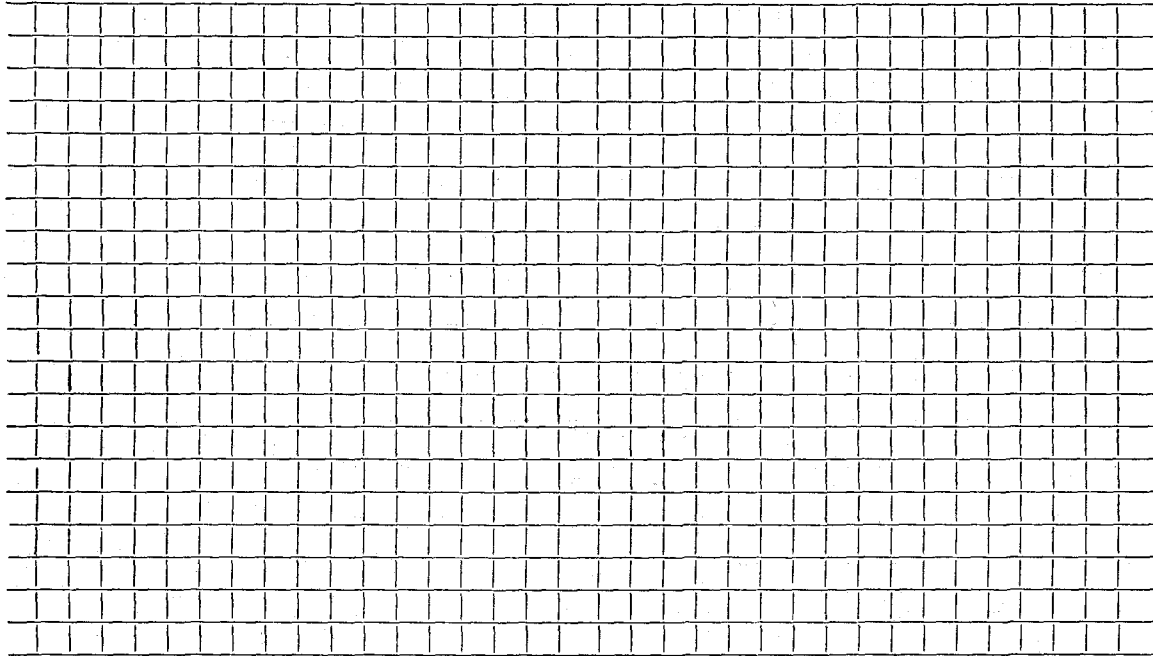

Connection made in Street. Work completed

Remarks: *Original Service 1521-50 (52'-6" Sewer Pipe, 1-6"-1/8" Bend)*

.....

.....