

Name John Powell

Service No. 19

Address 24 Reed Street

24 Reed Street

Location

Kind of Pipe

Size 6"

Size of Main 8"

~~Repair~~ Renewal ~~New Service~~ WCH 8585

Location JUN 29 1964

Date	Material	Amount	Total	Date	Amount
3-25-64	Labor 37.04			3-10-64	Deposit 125.00
3-26-64	" 43.22			3-31-64	Retard 44.45
5-12-64	" 12.58	92.84			80.55
	10% O.H.	9.28	102.12		
	40' 6" Transite pipe @.82		32.80		
	1 22 ¹ / ₂ " Transite Elbow		2.35		
	1 Duplex Adapter		1.62		
	3 x 3 Patch		3.00		
	2 yds. Loam @3.00		6.00		
	3 hrs. Town Shovel @6.50		19.50		
	2 hrs. Trucking @3.00		6.00		
	1 hr. Trucking @3.00		3.00		
			176.39		
			$176.39 \div 25 = 7.06 \times 11 \text{ yrs. } 5 \text{ mo.} = 80.55$		


DATE _____

TOWN OF LEXINGTON — BOARD OF PUBLIC WORKS

SEWER DIVISION

Sketch of Service Here

24

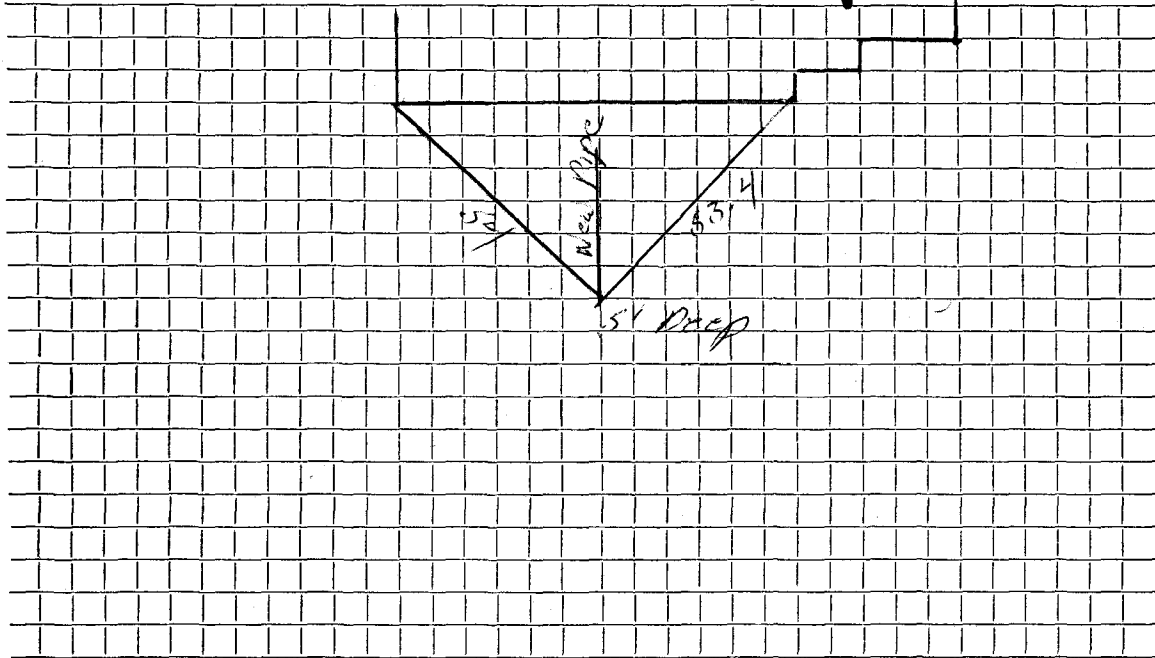

Connection made in Street. Work completed

Remarks: Original Service 10-22-52 (42'-6" Sewer Pipe, 1-6" Elbow).