

Name John F. Whalen

Service No. 95

Address 28 Reed Street

28 Reed Street

Location

Kind of Pipe

Size 6"

Size of Main 8"

~~Repair-Renewal~~ New Service W.O. #8821

Location DEC 28 1904

Date	Material	Amount	Total	Date	Amount
6-24-64	Labor	75 27		4-4-64	Deposit 250 00
	10% O.H.	7 53	82 80	12-28-64	Returned 119 26
	25' 6" Transite Pipe @.82		20 50		130 74
	1 Bag Cement		1 50		
	1 11 $\frac{1}{4}$ " Transite Elbow		2 35		
	1 11 $\frac{1}{4}$ " Transite Bend		4 09		
	2 Yds. Loam @3.00		6 00		
	1 Hr. Town Shovel @6.50		6 50		
	1 Hr. Trucking @3.00		3 00		
	1 Hr. Loader @4.00		4 00		
			130 74		


DATE _____

TOWN OF LEXINGTON — BOARD OF PUBLIC WORKS

SEWER DIVISION

Sketch of Service Here

28

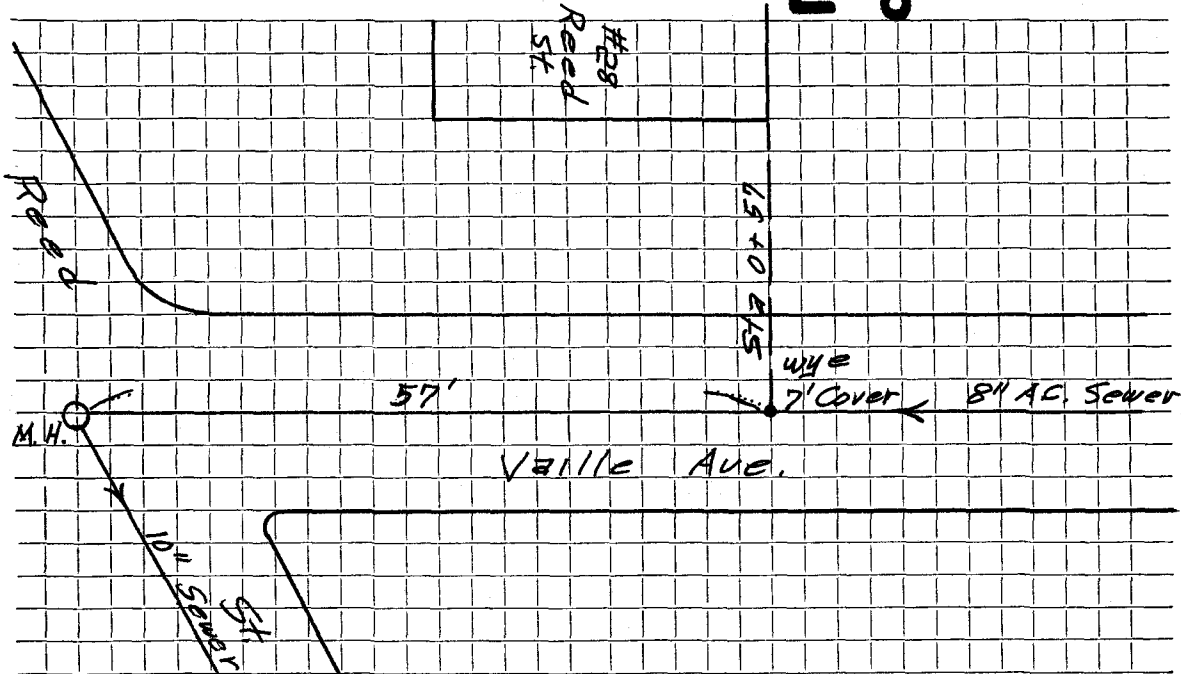

Connection made in Street. Work completed

Remarks:
.....
.....