

Name Raymond J. Doucette

Service No. 138

Address 33 Reed St. Lexington, Mass.

33 Reed Street

Location

Kind of Pipe

Size 6"

Size of Main 8"

Repair ~~XXXXXXXXXXXX~~ WO #4476


Location

Date	Material	Amount	Total	Date	Amount
11/13/75	labor	126. 08		11/13/75	Deposit 300. 00
4/22/76	labor	59. 91	184. 99	8-26-76	Paid 83. 60
	10%OH	18. 40	203. 39		383. 60
60'	6" transite pipe @ 1.48		88. 80		
2	36" nipples @ 8.25		16. 50		
1	1 1/2" sweep		3. 84		
1	T.C.B.		4. 39		
1	adapter		2. 43	1-23-75	Roots 35'
1/2 bag	cement		1. 50		Home owners <del>side</del>
1hr.	shovel		6. 50		
6hr.	truck @ 3.00		18. 00		
1ht.	loader		4. 00		
7lb.	grasseed @ .39		2. 73		
7yds.	loam @ 4.50		31. 50		
			383. 60		
				11-5-75	Block 35' x 78' out

DATE \_\_\_\_\_

TOWN OF LEXINGTON — BOARD OF PUBLIC WORKS  
SEWER DIVISION

Sketch of Service Here **33**

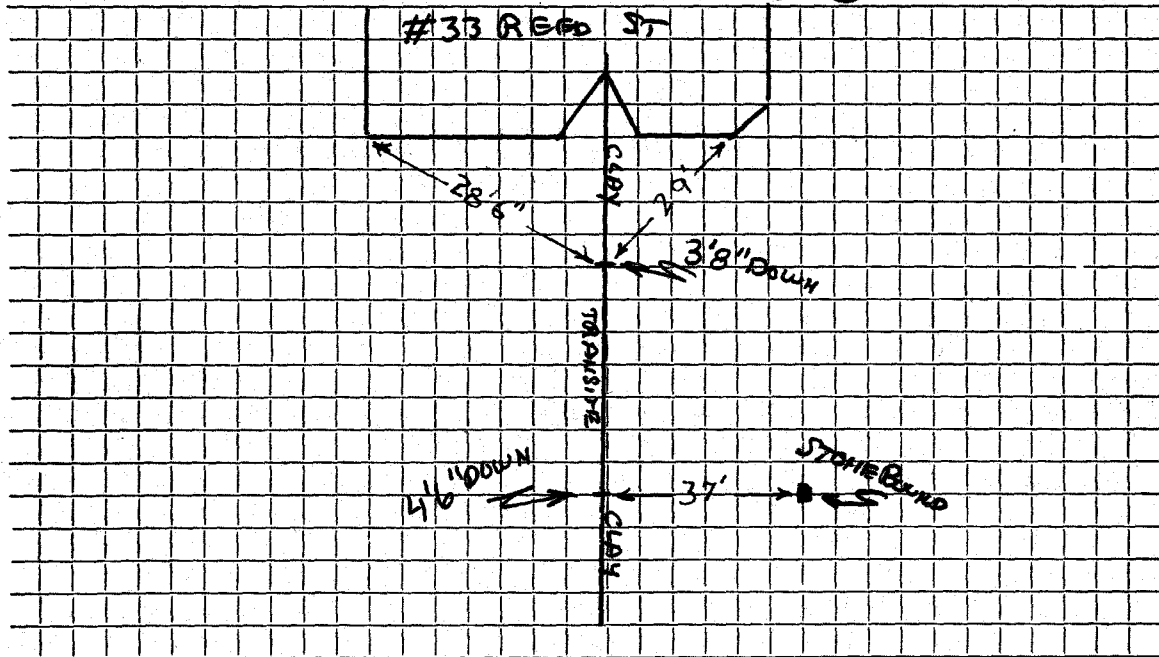

Connection made in ..... Street. Work completed .....

Remarks: Original Service 6-11-51 (186'-6" Sewer Pipe, 1-6" Elbow.)