

Name N.Y. Bros. Trust

Service No. 83

Address

35 Reed St

35 Reed Street

Location

Kind of Pipe

Size 6"

Size of Main 8"

Repair—Renewal—New Service Valeri #3116 W.O.#1158

Location FEB 10 1975

Date	Material	Amount	Total	Date	Amount
10/12/73	47' 6" Transite pipe			8-8-73	Deposit 140.00
	10' 4" Cast Iron pipe			5-10-75	Paid by WMC#33 55.71
3/17/73	Labor	88.85		5-11-75	Paid by WMC#33 8.88
	10% O.H.	8.89	97.74	6-13-75	Paid 7.30
	20' 6" Transite pipe @.99		19.80		231.89
	1 11 ¹ / ₄ " Transite Sweep		3.95		
	¹ / ₂ bag Cement		.55		
	4 3/4 ton Stone @3.50		16.63		
	1 6" Cap		1.77		
	10 x 11 Patch		73.20		
	1 ¹ / ₂ hrs. Town Shovel @6.50		9.75		
	1 ¹ / ₂ hr. Trucking @3.00		4.50		
	1 hr. Loader @4.00		4.00		
			231.89	1-27-86	Checks in Pipe
					Bill sent 7.30


DATE _____

TOWN OF LEXINGTON — BOARD OF PUBLIC WORKS

SEWER DIVISION

Sketch of Service Here

35

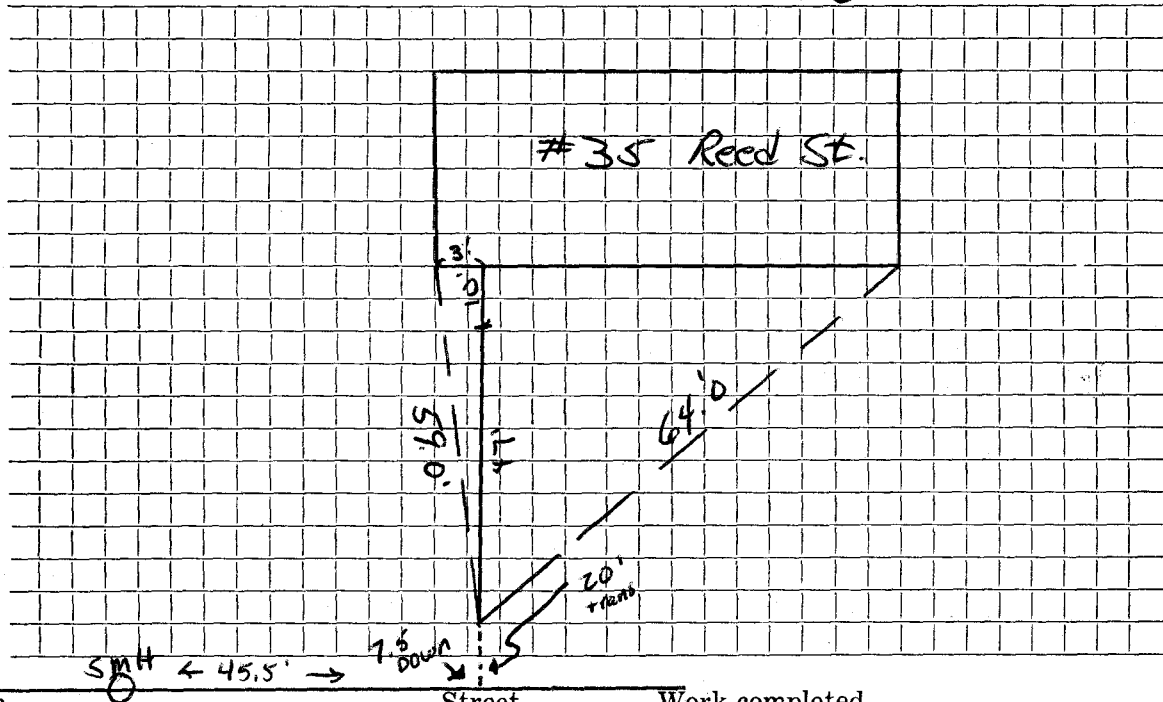

Connection made in Street. Work completed

Remarks:

.....

.....