

Name Florence Miller

Service No. #8

Address 4 Reed Street

4 Reed Street

Location

Kind of Pipe

Size 6"

Size of Main 8"

~~Repair~~ Renewal—New Service WO #7049

Location Conn 6-25-62

Date	Material	Amount	Total	Date	Amount
8-5-60	Labor	36 12		2-14-62	Deposit 200 00
	10% O.H.	3 61	38 73	6-25-62	Refund 39 68
	25' 6" Transite pipe @.78		19 50		160 32
	2 Hrs Town Shovel @6.50		13 00		
	1 Hr Trucking @3.00		3 00		
			74 23		
	BILL WHEN CONNECTED				RESPOND AND MEASURE
3-29-62	Labor 30.60	30.60		8-18-62	Roots possibly in connection
4-18-62	" 6.61	37.21			5' out
	10% O.H.	3.72	40.93		
	27' 6" Transite Pipe @.78		21.06		
	1 11 $\frac{1}{2}$ " Transite Bend		5.10		
	2 Hrs. Town Shovel @6.50		13.00		
	2 Hrs. TRuncking @3.00		6.00		
			160.32		


DATE _____

TOWN OF LEXINGTON — BOARD OF PUBLIC WORKS

SEWER DIVISION

Sketch of Service Here

4

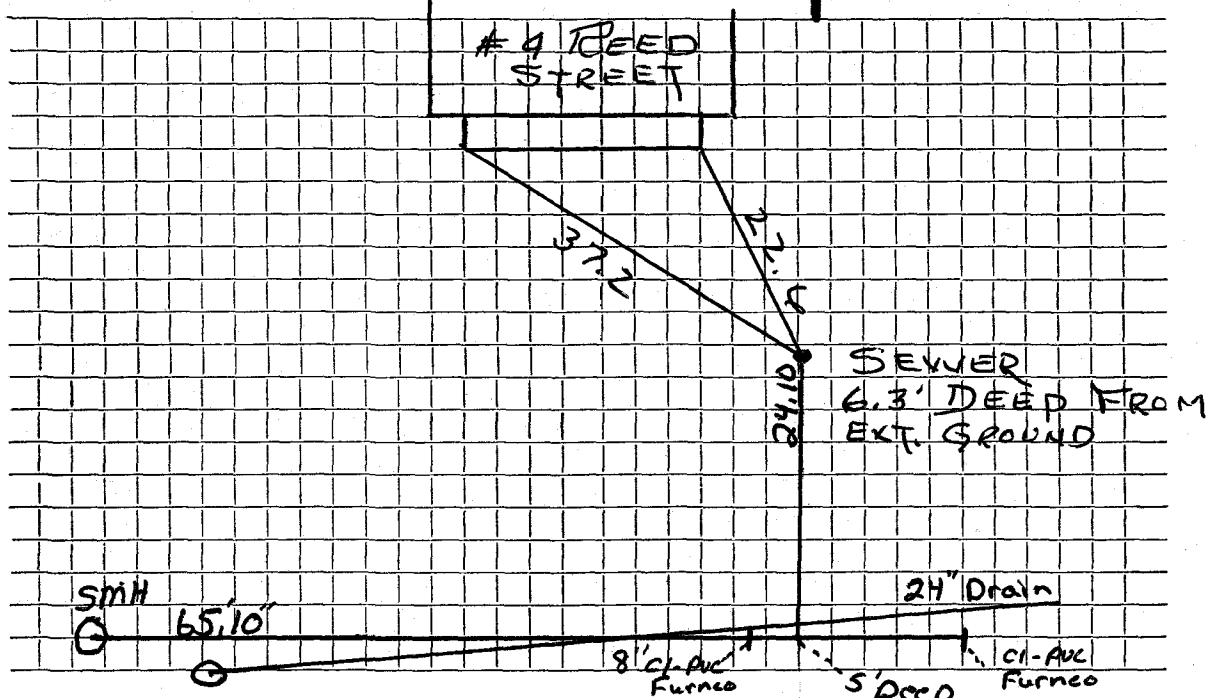

Connection made in Street. Work completed 9.22.92

Remarks: 2-8" CI-PVC Furnces., 1-6" AC-PVC Furnce., 1-8x8x6 Tee PVC