

Name Daniel Gorman

Service No. 6

Address 47 Reed Street

47 Reed Street

Location

Kind of Pipe

Size 6"

Size of Main 8"

~~Service Renewal~~ New Service W.O. #7797

Location Cam 5-27-63


Date	Material	Amount	Total	Date	Amount
4-15-63	Labor 28.83			3-11-63	Deposit 250.00
4-16-63	" 61.23	90.06		5-23-63	Refund 47.43
	10% O.H.	9.01	99.07		202.57
	50' 6" Transite pipe @.82		41.00		NON CHARGE
	5 hrs. Town Shovel @6.50		32.50	4-15-63	Labor 21.62
	4 hrs. Trucking @3.00		12.00		
	18 x 3 Patch		18.00		
			202.57		

DATE _____

TOWN OF LEXINGTON — BOARD OF PUBLIC WORKS

SEWER DIVISION

Sketch of Service Here **47**

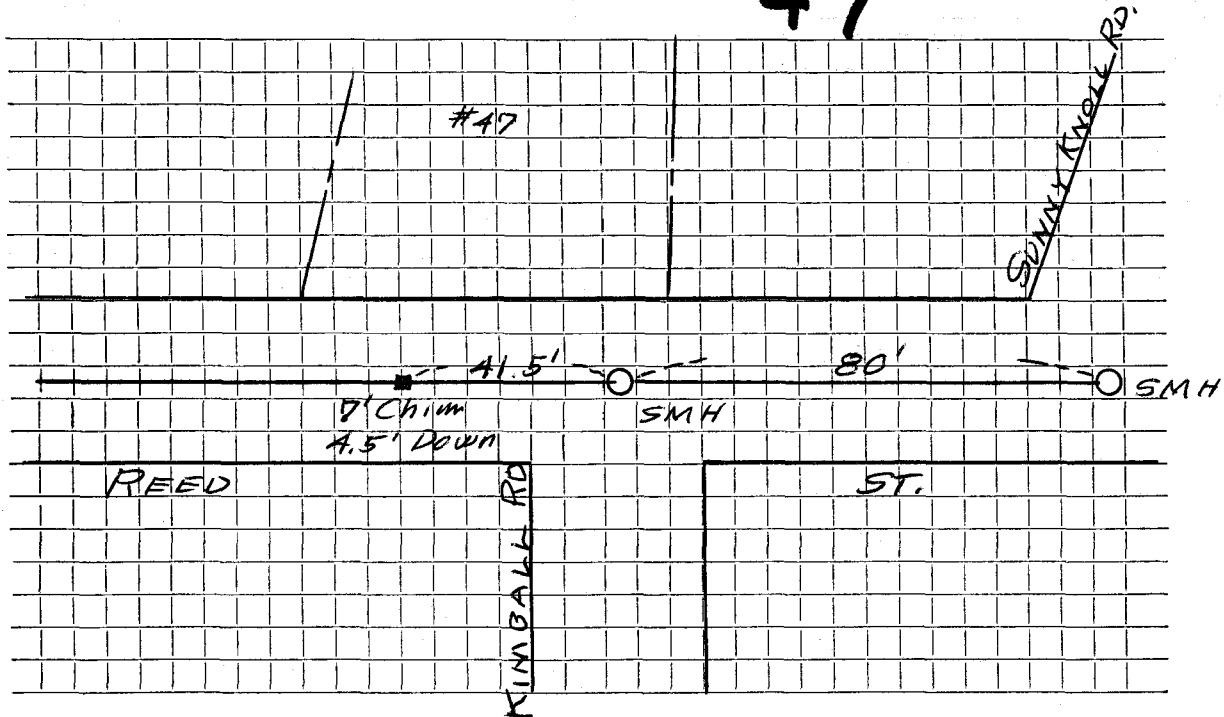

Connection made in Street. Work completed

Remarks:
.....
.....