


DATE _____

TOWN OF LEXINGTON — BOARD OF PUBLIC WORKS

SEWER DIVISION

Sketch of Service Here

53

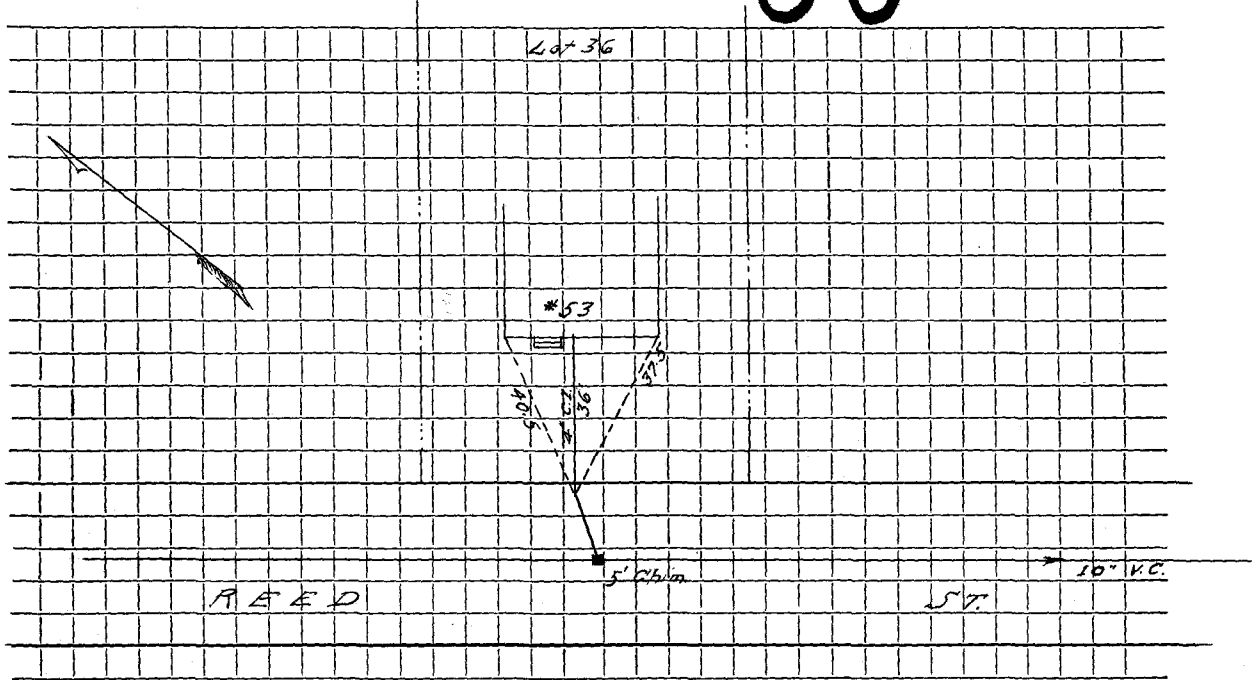

Connection made in Street. Work completed

Remarks: Original Service 6-21-49 (40'-6" Sewer Pipe, 1-6" Elbow)