

Name William Moreau

Service No. 171

Address 59 Reed Street

59 Reed Street

Location

Kind of Pipe

Size 6"

Size of Main 8"

~~Repair~~ ~~Renewal~~ — New Service

Location Conn 12-18-61

Date	Material	Amount	Total	Date	Amount
1/27/61	Labor	77 28		11-15-61	250 00
	10% O.H.	7 73	85 01	12-18-61	84 05
	44' 6" Transite Pipe @ .78		34 32		165 95
	1 Duplex Adapter		1 62		
	4 Hrs. Pippin Shovel @ 5.00		20 00		
	2 Hrs. Trucking @ 3.00		6 00		
	4 X 3 Patch		4 00		
	Loam & Seed (Spring)		15 00		
			165 95		




DATE 6/18/96

TOWN OF LEXINGTON — BOARD OF PUBLIC WORKS  
SEWER DIVISION

Drain

Sketch of Service Here 59

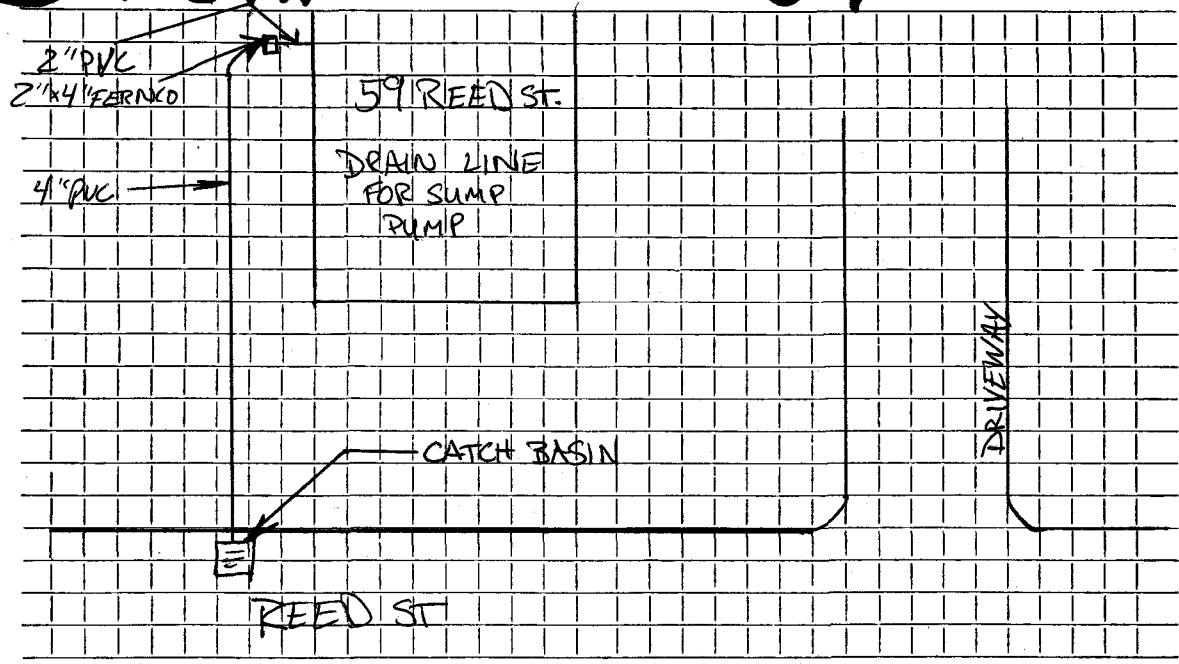

Connection made in ..... Street. Work completed .....

Remarks: .....  
.....  
.....

DATE \_\_\_\_\_

**TOWN OF LEXINGTON — BOARD OF PUBLIC WORKS**

**SEWER DIVISION**

Sketch of Service Here

A large grid of graph paper, consisting of 20 columns and 20 rows of small squares, intended for sketching service details.

Connection made in ..... Street.                      Work completed .....

Remarks: .....  
.....  
.....