




DATE \_\_\_\_\_

TOWN OF LEXINGTON — BOARD OF PUBLIC WORKS  
SEWER DIVISION

Sketch of Service Here

64

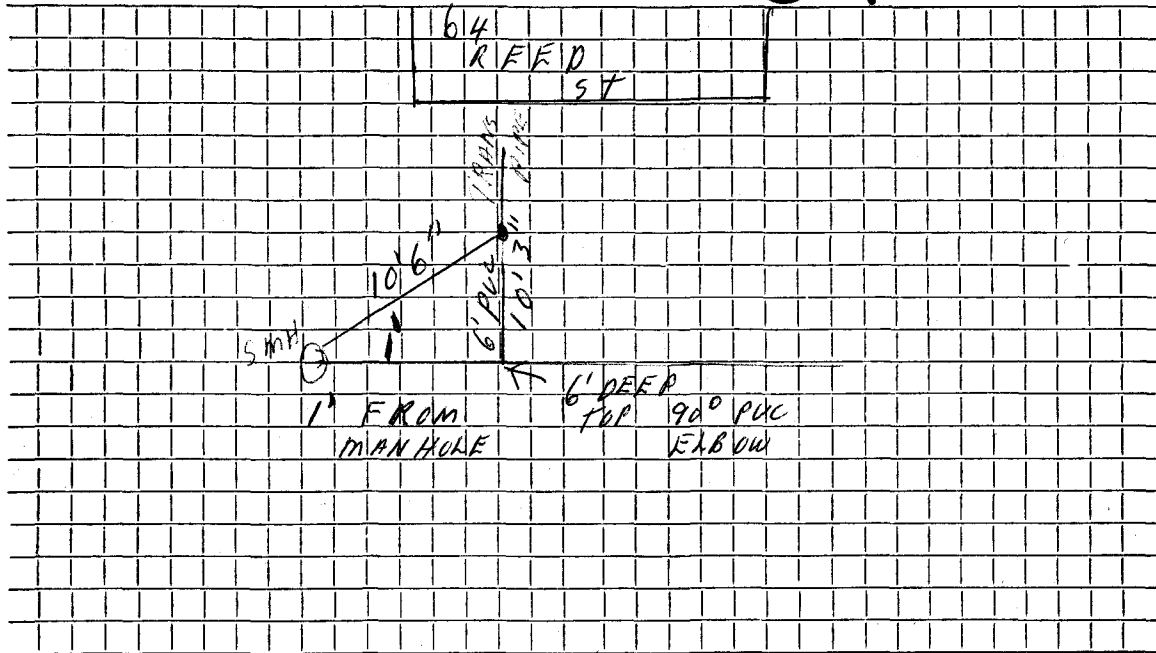

Connection made in ..... Street.

Work completed .....

Remarks: Original Service 10-13-59 (63'-6" Transite, 1'-6" 45° Elbow)