

Name Alford Peckham

Service No. 211

Address 67 Reed Street

67 Reed Street

Location

Kind of Pipe

Size 6"

Size of Main 8"

~~Repair~~ New Service

Location *Comm 3-16-59*

| Date    | Material                  | Amount | Total  | Date            | Amount        |
|---------|---------------------------|--------|--------|-----------------|---------------|
| 12-1-58 | Labor                     | 45.68  |        | <i>11-12-58</i> | <i>180.00</i> |
| 12-2-58 | Labor                     | 7.69   |        | <i>3-16-59</i>  | <i>5.54</i>   |
|         | 10% O.H.                  | 5.34   | 58.71  |                 | <i>124.56</i> |
|         | 42' 5" Transite pipe @.55 |        | 23.10  |                 |               |
|         | 9 ton 1 1/2 Stone @ 1.50  |        | 13.50  |                 |               |
|         | 6 x 3 patch               |        | 6.00   |                 |               |
|         | 3 hrs. Town Shovel @ 6.50 |        | 19.50  |                 |               |
|         | 1 hr. Trucking @.75       |        | .75    |                 |               |
|         | 1 hr. Trojan Loader @3.00 |        | 3.00   |                 |               |
|         |                           |        | 124.56 |                 |               |
|         | Labor                     |        |        |                 |               |

# TOWN OF LEXINGTON—DEPT. OF PUBLIC WORKS

## SEWER DIVISION

DATE.....

NO. ....


The undersigned applies for the construction of a particular sewer connecting No.....  
 Street and hereby agrees to comply with the Rules and Regulations governing the construction and use of Particular  
 Sewers, as now or at any future time established by the Board of Selectmen.

Am't of estimate \$.....

Am't Paid \$.....

..... Owner

Sketch of Service Here **67**

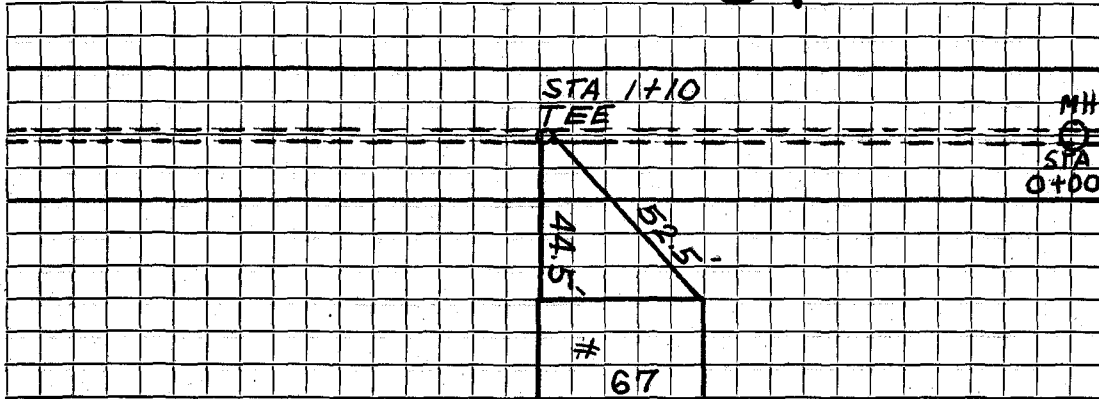

Connection made in..... Street.

Work completed.....19..

Remarks: