

Name Frank M. Hodgdon

Service No. 142

Address 70 Reed Street

70 Reed Street

Location

Kind of Pipe

Size 6"

Size of Main 8"

~~Repair/ Renewal~~ - New Service

Location *Canon 11-13-61*

Date	Material	Amount	Total	Date	Amount
10/14/61	Labor	85.84		10-9-61	200.00
	"	45.03	130 87	11-13-61	16.39
	10% O.H.	13 09	143 96	2-27-62	17.47
					216 39
	87' 6" Transite pipe @ .78		67.86		
	2 6" 22 1/2° Transite bends		12 42		
	1 6" 11 1/4° Transite Elbow		2 24		
	1 6" Duplex Adapter		1 90		
	17 X 3 Patch		17 00		
	3 Hrs. Town Shovel @ 6.50		19 50		
	1 Hr. Trailer @ 3.00		3 00		
	4 Hrs. Trucking @ 3.00		12 00		
			279 88		
				<i>Bill sent 63.49</i>	


DATE _____

TOWN OF LEXINGTON — BOARD OF PUBLIC WORKS

SEWER DIVISION

Sketch of Service Here

70

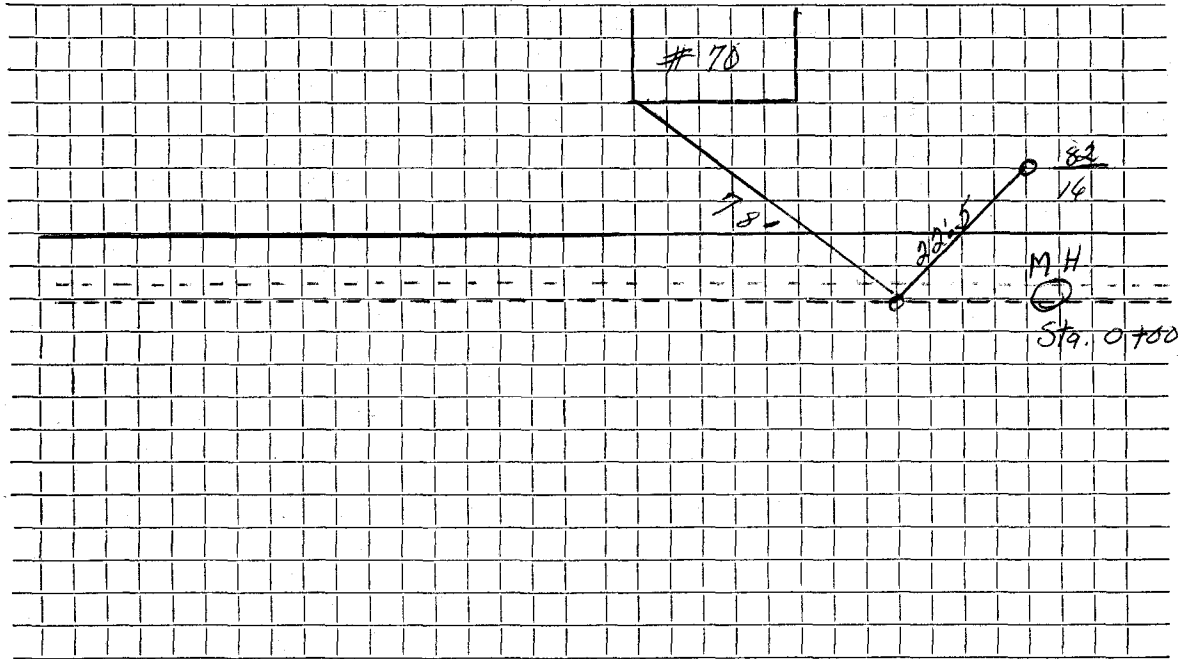

Connection made in Street. Work completed

Remarks:
.....
.....