

Name Ogden Construction Corporation

Service No. 186

Address 75 Reed Street

75 Reed Street

Location

Kind of Pipe

Size 6"

Size of Main 8"

~~Repair/Replace~~ New Service

Location Comm. 12-31-61

Date	Material	Amount	Total	Date	Amount
12/8/61	Labor	83 54		11-27-61	250 00
	10% O.H.	8 35	91 89	12-31-61	47 89
	49' 6" Transite Pipe @ .78		38 22		192 11
	4 Hrs. Town Shovel @ 6.50		26 00		
	2 Hrs. Trucking @ 3.00		6 00		
	20 X 3 Patch		20 00		
			182 11		
	Labor			12-30-82	S.B. 45' out
				7-25-83	S.B. 111 Kanawha
				12-21-88	S.B.
				1-29-01	JMar. Respond + Measure

TOWN OF LEXINGTON—DEPT. OF PUBLIC WORKS
SEWER DIVISION

DATE.....

NO.


The undersigned applies for the construction of a particular sewer connecting No.....
Street and hereby agrees to comply with the Rules and Regulations governing the construction and use of Particular
Sewers, as now or at any future time established by the Board of Selectmen.

Am't of estimate \$.....

Am't Paid \$.....

..... Owner

Sketch of Service Here

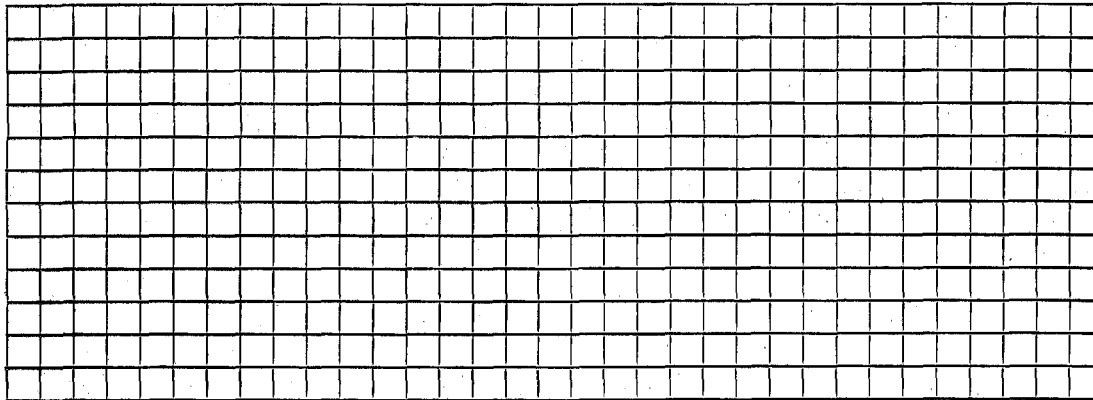

Connection made in..... Street.

Work completed.....19..

Remarks: