


DATE _____

TOWN OF LEXINGTON — BOARD OF PUBLIC WORKS
SEWER DIVISION

Sketch of Service Here

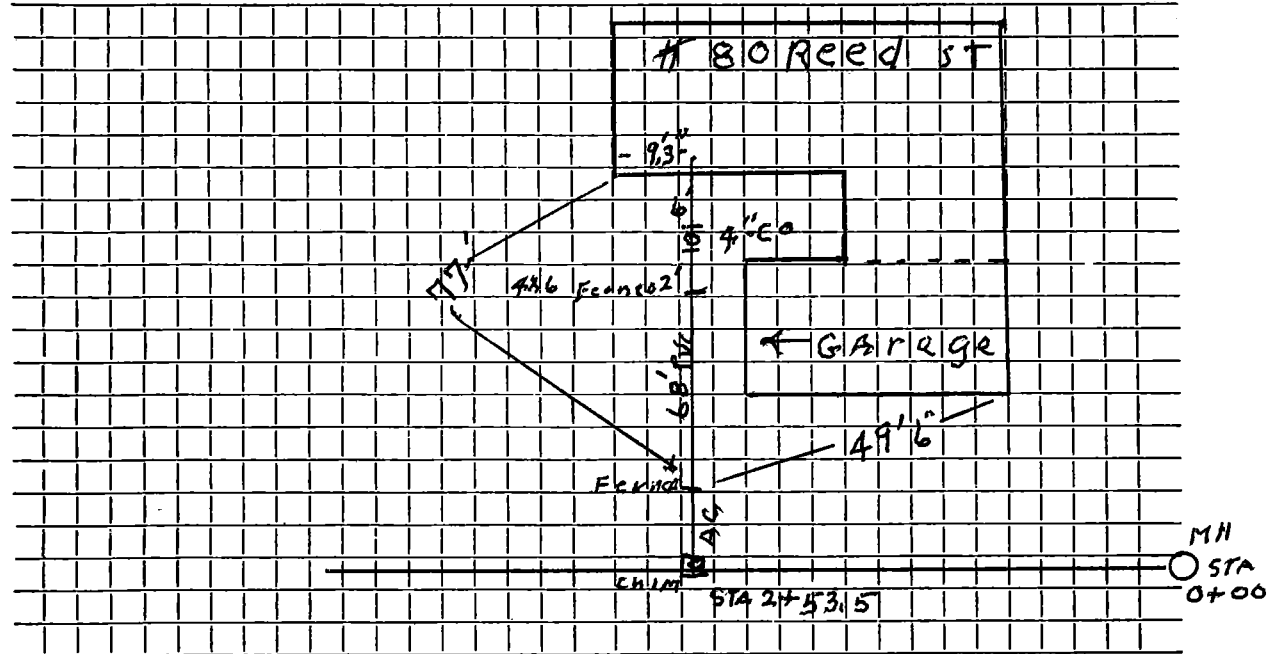

Connection made in Street.

Work completed .. 12/14/11 J. McLaughlin

Remarks: 6' Chim, 4' DLN w/90° Elbow

.....
.....