

Name Peter Stevenson

Service No. 207

Address 84 REED ST

84 Reed Street

Location

Kind of Pipe

Size 6"

Size of Main 8"

~~Repair/Removal~~ New Service

Location Comm 12-31-59

Date	Material	Amount	Total	Date	Amount
10-21-59	Labor	50.46		11-19-59	180 00
10-22-59	"	34.57	85.03	1-26-60	15 41
	10% O.H.	8.50	93.53		195 41
	65' 6" Transite Pipe @.70		45.50		
	1 6" Clay Elbow 45°		1.88		
	6 hrs. Pippin Shovel @6.50		39.00		
	2 hrs. Trucking @.75		1.50		
	14 X 3 Patch		14.00		
			195.41		
				3-12-80	Possible Rpts
	Labor				
				Bill sent 12-31-59	15.41

TOWN OF LEXINGTON—DEPT. OF PUBLIC WORKS

SEWER DIVISION

DATE.....

NO.


The undersigned applies for the construction of a particular sewer connecting No.....
 Street and hereby agrees to comply with the Rules and Regulations governing the construction and use of Particular
 Sewer, as now or at any future time established by the Board of Selectmen.

Am't of estimate \$.....

Am't Paid \$.....

..... Owner

Sketch of Service Here **84**

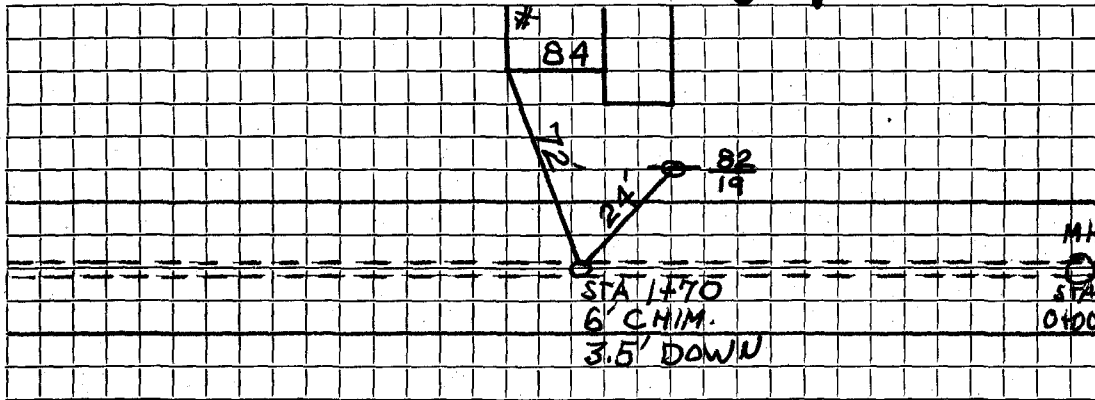

Connection made in..... Street.

Work completed.....19..

Remarks: