

Name Barry T. O'Shaughnessy

Service No.

Address 85 REED ST.

85 Reed Street

Location

Kind of Pipe

Size 6"

Size of Main 8"

~~REPAIR~~ - New Service Russell Sibley Permit #255

Location OCT 25 1965

Date	Material	Amount	Total	Date		Amount
4-14-65	Labor	37 32		4-1-65	Deposit	115 00
	10% O.H.	3 73	41 05	11-25-65	Retained	32 36
	17' 6" Sewer Pipe @.82		13 94			82 64
	1 90% Ell		4 09			
	1 Duplex Adaptor		2 06			
	12'X3' Patch		12 00			
	1 Hr. Town Shovel		6 50			
	1 Hr. Town Truck		3 00			
			82 64			
5-1-65	23' 6" Transite					
	Labor					

**TOWN OF LEXINGTON—DEPT. OF PUBLIC WORKS**  
**SEWER DIVISION**

DATE.....

NO. ....

The undersigned applies for the construction of a particular sewer connecting No.....  
 Street and hereby agrees to comply with the Rules and Regulations governing the construction and use of Particular  
 Sewer, as now or at any future time established by the Board of Selectmen.


Am't of estimate \$.....

Am't Paid \$.....

..... Owner

Sketch of Service Here

85

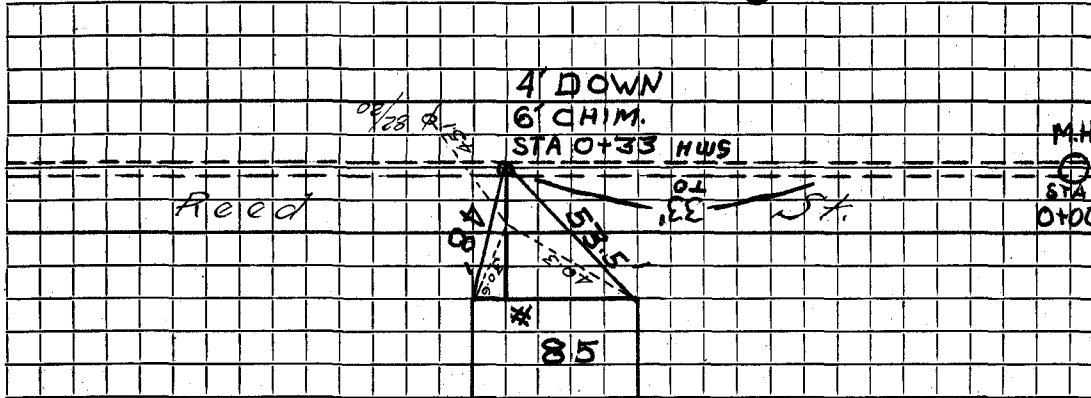

Connection made in..... Street.

Work completed.....19..

Remarks: