

Name Katherine Heller

Service No. 192

Address 86 Reed Street

86 Reed Street

Location

Kind of Pipe

Size 6"

Size of Main 8"

~~Repair~~ Renewal New ServiceLocation *Comm 3-16-59*

| Date    | Material                  | Amount | Total  | Date              |                            | Amount |
|---------|---------------------------|--------|--------|-------------------|----------------------------|--------|
| 11-6-58 | Labor                     | 23.25  |        | 10-30-58          | Deposit                    | 180.00 |
| 11-7-58 | "                         | 89.44  | 112.69 | 3-24-59           | Paid                       | 58.15  |
|         | 10% O.H.                  |        | 11.27  |                   |                            | 238.15 |
| 56'     | 6" Transite pipe @.70     |        | 39.70  |                   | NON CHARGE                 |        |
| 1       | 6" Transite Elbow 90°     |        | 5.29   | 11-8-58           | Labor                      | 100.75 |
| 2       | 11½° Transite Bends @5.10 |        | 10.20  | 1                 | hr. Town Shovel @6.50      | 6.50   |
| 4½      | ton 1½" Stone @1.50       |        | 6.75   |                   |                            | 107.25 |
| 24      | x 3 Patch                 |        | 24.00  |                   | REPAIR W.O. #654           |        |
| 4       | hrs. Town Shovel @6.50    |        | 26.00  | 11/7/84           | 5' x 3/4" Copper           |        |
| 3       | hrs. Trucking @.75        |        | 2.25   | 1                 | 3/4" Corp                  |        |
|         |                           |        | 238.15 | 1                 | Curb Box & Rod             |        |
|         |                           |        |        | 1                 | 1½" Plug                   |        |
|         | Labor                     |        |        | 2                 | 6" PVC to AC Fernco Adapt. |        |
|         |                           |        |        | 11-5-83           | <i>Roots in chimney</i>    |        |
|         |                           |        |        | Bill sent 3-16-59 |                            | 58.15  |

**TOWN OF LEXINGTON—DEPT. OF PUBLIC WORKS**  
**SEWER DIVISION**

DATE.....

NO. ....


The undersigned applies for the construction of a particular sewer connecting No.....  
 Street and hereby agrees to comply with the Rules and Regulations governing the construction and use of Particular  
 Sewer, as now or at any future time established by the Board of Selectmen.

Am't of estimate \$.....

Am't Paid \$.....

..... Owner

Sketch of Service Here **86**

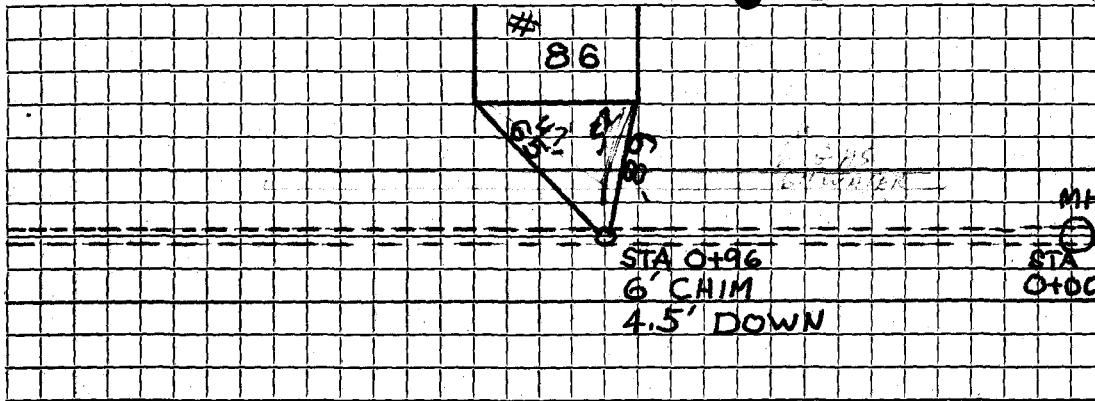

Connection made in 12'-6" PVC UNDER GAS Street. Work completed.....19..

Remarks: WATER MAIN 2-6" FRENCO COUPLING  
THE SEWER SERVICE IS UNDER THE GAS SERVICE