


DATE _____

TOWN OF LEXINGTON — BOARD OF PUBLIC WORKS

SEWER DIVISION

Sketch of Service Here **9**

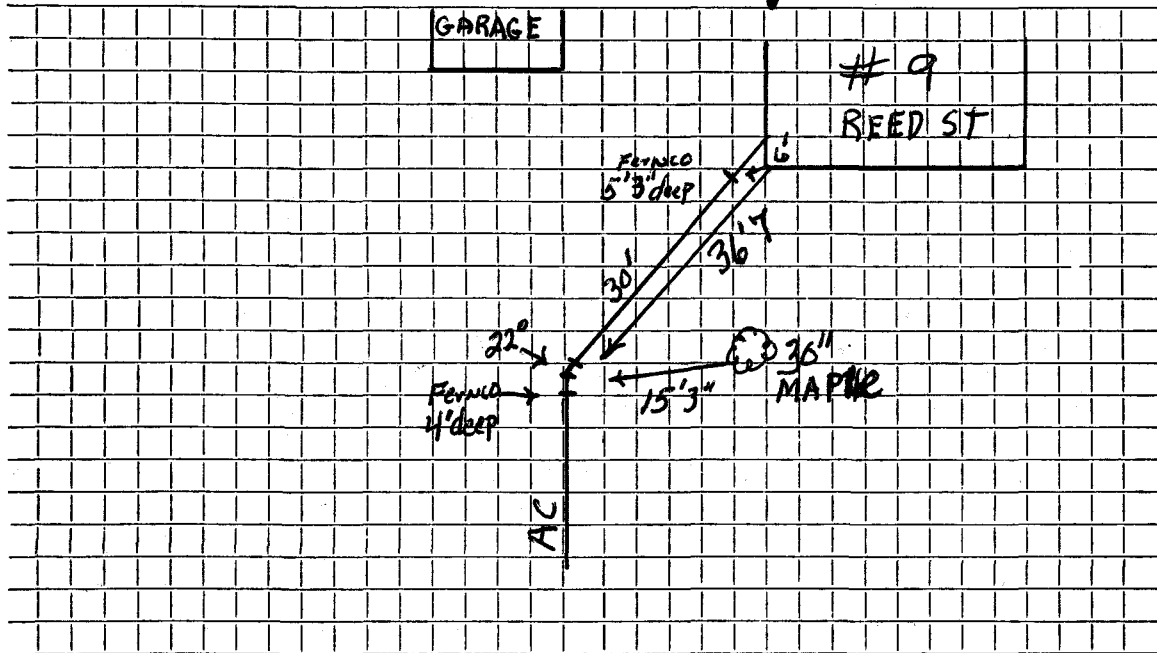

Connection made in Street. Work completed

Remarks: 3-30-88 AC Pipe Clear To Elbow of MW

.....
.....